
Saline

KANSAS

SECTION 4 TOWNSHIP 16S RANGE 3W

WELL NO. #1 Thelander

COMPANY Reese & Sanderson

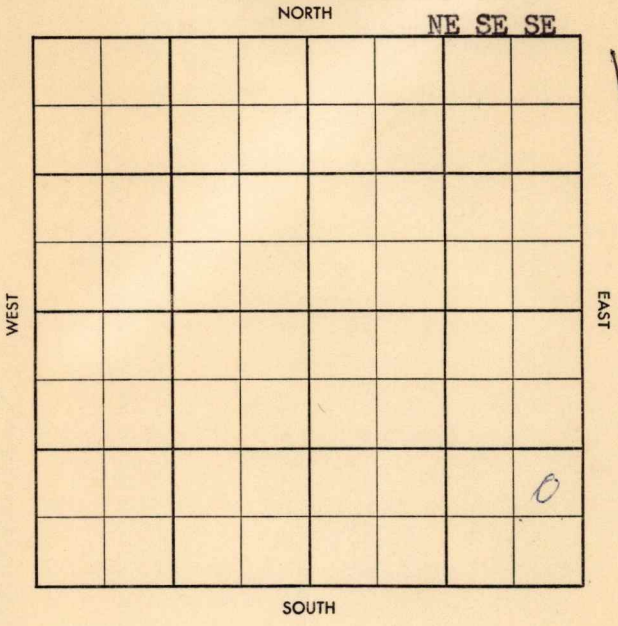


FORM 504-3 SUNRAY

Home DK
1908 McPherson

S-513-B

County Saline Elev. 1302KB 1301DF

Sec. 4 Twp. 16 Rge. 3W

Company Reese and Sanderson

Farm Name Thelander No. 1

| TOPS | DEPTH | LOG | DATUM |
|---|---|---|---|
| Anh. | | | |
| Tp. | | | |
| H. | | | |
| Tr. | | | |
| Dg. | | | |
| B.L. | | | |
| L. | | | |
| K.C. | | | |
| B.K.C. | | | |
| Ce. | | | |
| C. | 2820 | | |
| M. | | | |
| M. | | | |
| K. | | | |
| Mz. | | | |
| Mq. | 3299 | | |
| V. | 3360-3446 | | |
| S. | | | |
| S. | | | |
| A. | | | |
| R. | | | |
| Pf. | | | |
| G. | | | |
| T.D. | 3501 | | |

Loc. in Sec. NE SW SE

Geol. Don Melland

Contr. [illegible]

Pool Olsson

ABANDONED

APR 16 '58

Date Comm. 3/25/58

Date Plug. APR 2 '58 / APR 9 '58 APR X '58

8" 284/225 ø2857

no log

D-6A

Co. Lse. No. Sec. T. R.

Twp. X Pool X

Co. X Facet X

S–513-B

County Saline Elev.

Sec. 4 Twp. 16 Rge. 3W

Company Reese and Sanderson

Farm Name Thelander No. 1

| TOPS | DEPTH | LOG | DATUM |
|---|---|---|---|
| Anh. | | | |
| Tp. | | | |
| H. | | | |
| Tr. | | | |
| Dg. | | | |
| B. L. | | | |
| L. | | | |
| K.C. | | | |
| B.K.C. | | | |
| Ce. | | | |
| C. | | | |
| M. | | | |
| M. | | | |
| K. | | | |
| Mz. | | | |
| Mq. | | | |
| V. | | | |
| S. | | | |
| S. | | | |
| A. | | | |
| R. | | | |
| Pf. | | | |
| G. | | | |
| T.D. | | | |

Loc. in Sec. NE SE SE

Geol.

Contr. Greenland

Pool Olsson




Date Comm. 3/25/58

Drlg.

Co. Lse. No. Sec. T. R.