


Section 22 Township 14 Range 13 W

Well No. # 3 Jones "B"

Company Duke & Wood

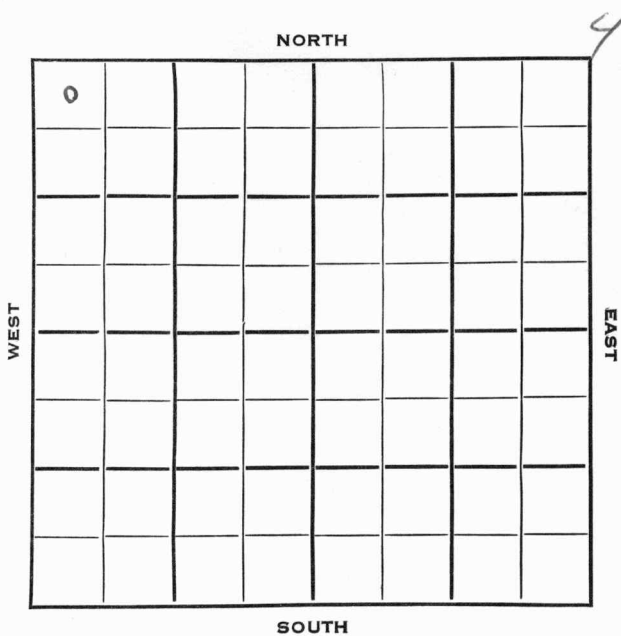

Russell **KANSAS** ✓

Sec. 22 Twp. 14 R. 13W

Well No. #3 Jones "B" Farm

Duke & Wood Company

Duke & Wood Contractor


330 Ft. from N. Line

\_\_\_\_\_ Ft. from S. Line

\_\_\_\_\_ Ft. from E. Line

330 Ft. from W. Line

NW NW NW

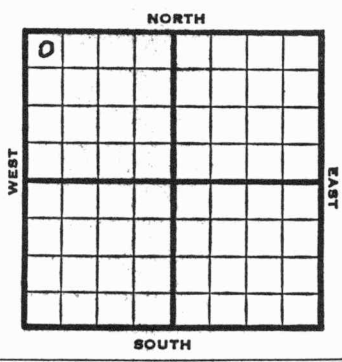

1953 Elev. 1841' REPORT

5/13 Spud 5-8-53  
8" @ 274  
Anhy 774  
Drlg. 1840'

5/21 Tarkio 2358' RTD 2395  
5" @ 2395

5/28 N.R.

6/3 Spud 5-8-53  
Oil Well  
TD 2395'  
8" @ 274'  
Anhy 774, Tarkio 2358,  
TD 2395'  
5" @ 2395'  
CO to 2375  
Perf 2361-66 S/ 1/2 boph sd-oil-frac  
1 1/2 boph  
Comp 25 bopd.

**COMPLETED**

County **Russell** State **Kansas**

Sec. **22** (Blk. Twp.) **14** (Sur. Rge.) **13W** Map No.

Operator **Duke & Wood**

Well No. **3** Farm **Jones "B"**

Elev. Location **NW NW NW**

0					

**330** Ft. From **N** Line **NW**

**330** Ft. From **W** Line Quarter

1st. Report **MAY 13 1953**

Completion

Remarks

**Duke & Wood - Contr.**

Spudding Date **5-8-53**

Drlg. Data

**8" @ 274 Anhy 774 drlg. 1840**

County Russell State Kansas

Sec. 22 (Blk. 14 (Sur. 13W Map No. (Twp.) (Rge.))

Operator Duke & Wood

Well No. 3 Farm Jones "B"

Elev. 1841 Location NW NW NW

6				

330 Ft. From N Line NW

330 Ft. From W Line Quarter

1st. Report

Completion JUN 3 1953

Remarks

Duke & Wood - Contr.

Spudding Date 5-8-53

**COMPLETE**

Drilg. Data Oil well TD 2395

8" @ 274 Anhy 774 Tarkio 2358

TD 2395 5" @ 2395 CO to 2375

perf/ 2361-66 S/  $\frac{1}{2}$  boph sd-oil-frac

$\frac{1}{2}$  boph Comp. 25 bopd