


Section 22 Township 14 Range 13-W

Well No. #1 J. E. Missimer

Company Stanolind

Hall Gurney Pool

NORTH

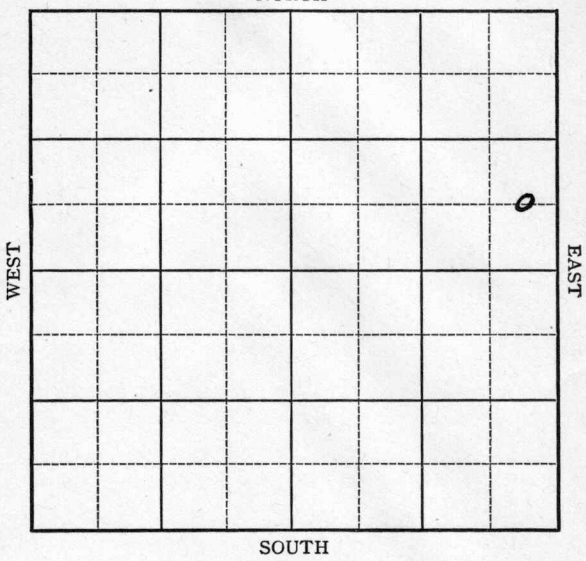

8

o


WEST

EAST

SOUTH

Sec. 22 Twp. 14 R. 13-WWell No. #1 J. E. Missimer FarmStanolind Company
(Hall Gurney) Ft. from N. Line660 Ft. from S. Line330 Ft. from E. Line Ft. from W. Line

Elev. 1777

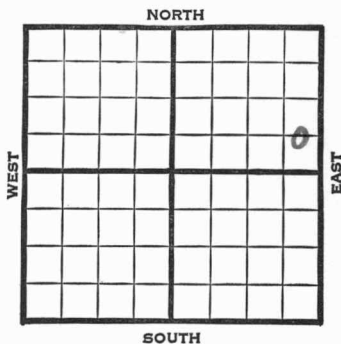

1941

REPORT

5/7

Location

5/15

Pits.

5/22

Cable.

5/28

20" - 27' Drlg. 295'

6/5

16" - 309' 13" - 529'

Anhy. 714' 10" - 723'

Drlg. 770'

6/12

Drlg. 1620'

6/19

1 bbl. oil per hour 2285-90'

S. gas 2290-95' Drlg. 2355'

6/26

8" - 2413' S.S.O. 2625-35'

SSO 2782-90' Lans. ~~2912'~~ 2917'

7" - 2922' Drlg. 2966'

7/3

Lans. 2917' (Corrected)

Cong. 3206' SSO 2941-44'

Drlg. 3225'

7/10

Arb. 3225' water.

Reagan 3265' T.D. 3271' H.F.W.

OVER

194
7/16

Reagan 3265'
T.D. 3271'
Water.

ABANDONED

Map No. 72 Sec. 22 Twp. 14 R. 13W

Well No. 1 J. E. Missimer

Stanolind Company

~~FIRST REPORT~~ Contractor

C E L S E N E

SECTION PLAT

			o

 Ft. from N. Line

660 Ft. from S. Line

330 Ft. from E. Line

 Ft. from W. Line

HALL GURNEY POOL

Location X

Rig up

Drilling and Remarks:

RECORD

Cased in., ft.

Sand

Gas

Oil

Total Depth

PRODUCTION

1st 24 hrs. Nat.

1st 24 hrs. after shot

Gas Cu. Ft.

Dry Hole

Abandoned

Date

MAY 7 1941 19

S. J. LEWIS Scout

Map No. 72 Sec. 22 Twp. 14 R. 13W

Well No. 1 J. E. Missimer

Stanolind Company

Contractor

ABANDONED

C E L S E N E

 Ft. from N. Line

660 Ft. from S. Line

330 Ft. from E. Line

 Ft. from W. Line

HALL GURNEY POOL

SECTION PLAT

			o

Location

Rig up

Drilling and Remarks:

*Reagan 3265
Water.*

RECORD

Cased in., ft.

Sand

Gas

Oil

Total Depth 3271

PRODUCTION

1st 24 hrs. Nat.

1st 24 hrs. after shot

Gas Cu. Ft.

Dry Hole

Abandoned

Date

JUL 16 1941 19

S. J. LEWIS Scout