


Section 22 Township 14 Range 13W

Well No. #7 Campbell

Company Lewis Mai

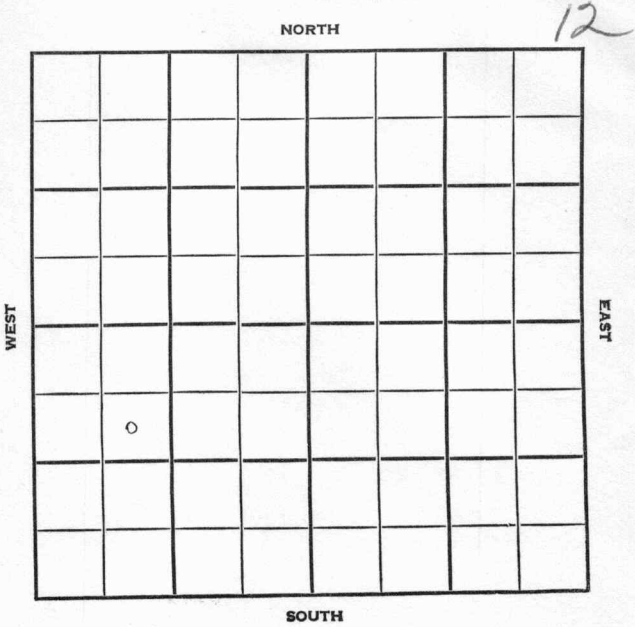

Russell

SEC.	TWP.	R.
22	14	13W

WELL NO. \_\_\_\_\_

#7 Campbell FARM

COMPANY \_\_\_\_\_

Lewis Mai

CONTRACTOR \_\_\_\_\_


Co. Tools.  
Hall-Gurney Pool NORTH

990 \_\_\_\_\_ Ft. from N. Line

\_\_\_\_\_ Ft. from S. Line

\_\_\_\_\_ Ft. from E. Line

990 \_\_\_\_\_ Ft. from W. Line

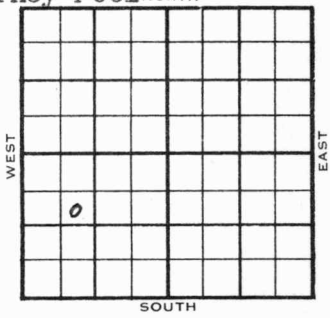

SE NW SW

	ELEVATION	REPORT
1954	1763' DF	

9/1

RUST

9/29

Spud 9-1-54  
Oil Well  
TD 2307'  
15" @ 40'  
12" @ 204'  
10" @ 405'  
Anhy 702'  
8" @ 706'  
Tarkio 2278',  
1 boph  
TD 2307'  
5" @ 2300  
CO to 2303  
sd-frac. S/ 7 boph  
Comp 25bopd.

COMPLETED



