


Section 36 Township 34 Range 2 E

Well No. # 1 Airport

Company O. H. Parker

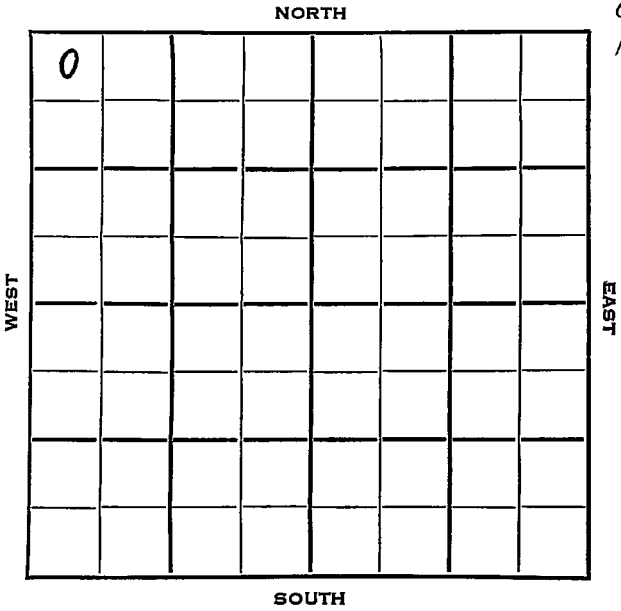

Summer **KANSAS**


SEC. 36 TWP. 34 R. 2 E

WELL NO. # 1 Airport FARM

COMPANY O. H. Parker

CONTRACTOR M & C

330 Ft. from N. Line
 Ft. from S. Line
 Ft. from E. Line
 330 Ft. from W. Line
 NW NW NW

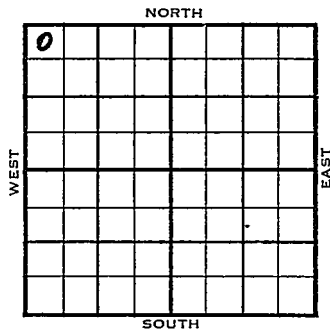

1953 ELEVATION 1235' REPORT

10/7 Location

11/11 Spu d 10-12-53
 Oil Well
 TD 3515'
 8" @ 111
 Stal. 2371', Layton 2808', KC 3004'
 DST 2815-25, opn 1 hr., gas in 6 mins.
 37,680 gas, 145' ho & gcm, 1065#
 Oswego 3210, Cherokee 3312', Bart
 3507'
 DST 3507-15, opn 1 hr., gas in 6 mins.
 42,000 gas, 180' oil, 60' mco, 60'
 ocm, 1130#
 6" @ 3507'
 CO to 3515, S/2 boph
 Comp. 35 bopd

COMPLETED

County Sumner State Kansas

Sec. 36 (Blk. 34 (Sur. 2E (Twp.) 24 (Rge.) 2E Map No.

Operator O. H. Parker

Well No. 1 Farm Airport

Elev. 1235 Location NW NW1/4

o					

330 Ft. From N Line NW

330 Ft. From W Line Quarter

Ist. Report OCT 7 1953

Completion

Remarks

M & C - Contr.

Spudding Date

Drig. Data

Location

Check Township
Think Twp 34

11/15

OCT 16 1953


[Handwritten scribble]

[Handwritten signature]

Orig. Date

County Sumner State Kansas

Sec. 36 (Blk. Twp.) 34 (Sur. Rge.) 2E Map No.

Operator O. H. Parker

Well No. 1 Farm Airport

Elev. 1235 Location NW NW NW

0						

330 Ft. From N Line NW

330 Ft. From W Line Quarter

Ist. Report

Completion NOV 11 1953

Remarks

M & C - Contr.

Spudding Date 10-12-53

Drlg. Data Oil well TD 3515

8" @ 111 Stal. 2371 Layton 2808

KC 3004 DST 2815-25 open 1 hr. Gas

in 6 min. 37,680.0 gas 145' ho & gcm

1065# Oswego 3210 Cherokee 3312

Bart. 3507 DST 3507-15 open 1 hr.

gas in 6 min. 42,000 gas 180' oil

60' mco 60' ocm 1130# 6" @ 3507

CO to 3515 S/ 2 boph Comp. 35 bopd