

Russell


KANSAS

DX 78-1

Section 23 Township 14 Range 13W

Well No. #1 Steinle

Company Advance Drlg.

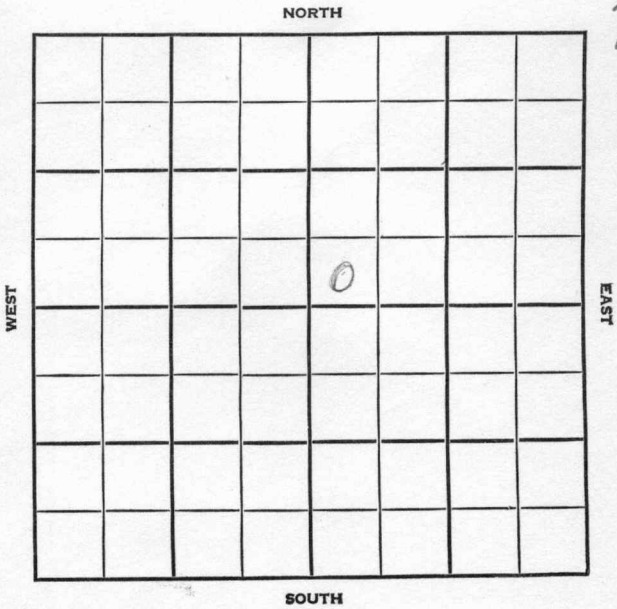

County Russell Elev. _____
 Sec. 23 Twp. 11 Rge. 13W
 Company Advance Drlg.
 Farm Name Steinle No. 1

Co.

TOPS	DEPTH	LOG	DATUM	Loc. in Sec.									
Anh.				SW SW NE									
TP.													
H.													
Tr.													
Dg.													
Bl.													
L.				Geol. _____									
K.C.				Contr. _____									
B.K.C.													
Ce.				Co. tools									
C.													
M.				Pool									
M.				Hall-Gurney									
K.				<table border="1"> <tr> <td></td> <td></td> <td></td> </tr> <tr> <td>DEC</td> <td>5</td> <td>30</td> </tr> <tr> <td></td> <td>0</td> <td></td> </tr> </table>				DEC	5	30		0	
DEC	5	30											
	0												
Mz.													
Me.													
V.													
S.													
S.													
A													
R.													
PE.													
G.				FIRST REPORT									
T.D.													

Lse.

No.

Date Comm. Cellar & pits

Sec.

T.

R.

13

County Russell Elev. 1784
 Sec. 23 Twp. 14 Rge. 13W
 Company Advance Drlg.
 Farm Name Steinle No. 1

TOPS	DEPTH	LOG	DATUM	Loc. in Sec.
Anh.				SW SW NE
Tp. <u>TARK</u>	<u>2282</u>			<u>TWIN ?</u>
H.				
Tr.				
Dg.				
Bl.				
L.				
K.C.				Geol.
B.K.C.				Contr.
Ce.				Co. tools
C.				
M.				Pool
M.				Hall-Gurney
K.				
Mz.				
Me.				
V.				
S.				
S.				
A.				
R.				
PE.				
G.				
TD.	<u>2340</u>			

ABANDONED
 0
 JAN 16 '57

Date Comm. DEC 12 '56 TARKIO Gas well
Cellar & pits RUR DEC 19 '56
12-12-56 858 380 425
DEC 26 '56 JAN 2 '57 1500
JAN 9 '57 2130 JAN 16 '57

D&A

Co. Lse. No. Sec. T. R