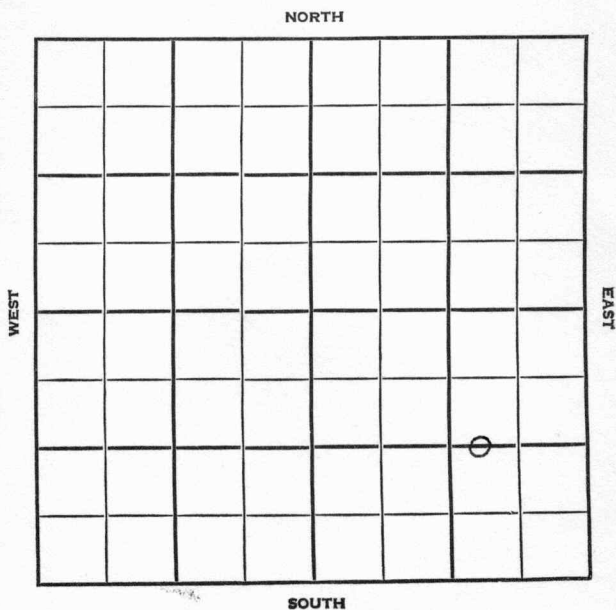


DX 78-1

Section 23 Township 14 Range 13 WWell No. #1 SteinleCompany Mast Drlg.

Russell

KANSAS

SEC. 23	TWP. 14	R. 13W
---------	---------	--------

WELL NO.

#1 Steinle

FARM

COMPANY

Mast Drlg

CONTRACTOR

Co. Tools


Hall-Gurney

Ft. from N. Line

Ft. from S. Line

Ft. from E. Line

Ft. from W. Line

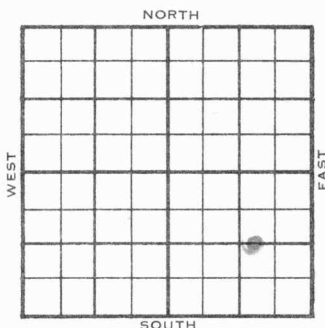C W $\frac{1}{2}$ E $\frac{1}{2}$ SE

1955

ELEVATION

1736'

REPORT

8/3

Comm. 7-26-55

FIRST REPORT

8" @225/125 Drlg. 2694.

9-7

DST 2897-2910, open 1 hr., rec. 34' ocm
BHP 0DST 3064-77, open 20", rec 3' md bhp
820# 20"DST 3101-10 open 1 hr. Rec. 150' sw
BHP 760# 25"

5 1/2" 3175

FU 2300' oil 12 hrs POP

Pmp 50 bopd no wtr.

TOPSDEPTH

Anh

671

Tp.

2571

K.C. 2873

A

3174

T.D. 3177'

COMPLETED

Co.

Co.

Co.

Co.

Co.

Co.

Co.

Co.

Co

Use:

No.

Sec.

7.

ス

County Russell Elev. 1736Sec. 23 Twp. 14 Rge. 13WCompany Mast Drlg.Farm Name Steinle No. 1

TOPS

DEPTH

LOG

DATUM

Loc. in Sec.

Anh. 671 835 C W/2 E/2 SETp. 2571

H.

Tr.

Dg.

BL.

L.

K.C.

28731137

Geol.

B.K.C.

Contr.

Ce.

C.

Co. tools

M.

M.

K.

Mz.

Mq.

V.

S.

S.

A.

31741438

COMPLETE

R.

P.C.

G.

T.D.

3177Date Comm. 7/26/55

SEP 7 1955

8" 225 w/125 DST 2897-2910 open 1 hr.

Rec. 34' ocm BHP 0 DST 3064-77 open 20"

Rec. 3' md bhp 820# 20" DST 3101-10 open

1 hr Rec. 150' sw BHP 760# 25" 5 $\frac{1}{2}$ " 3175

FU 2300' oil 12 hrs POP

Pmp 50 bopd no wtr