


Section 5 Township 16 Range 3w

Well No. 2 Johnson

Company T.A. Phillips & Sanderson

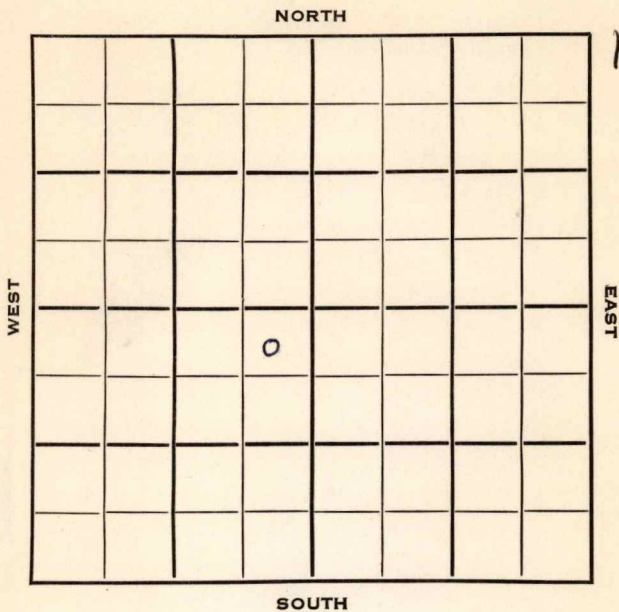

Sec. 5 Twp. 16 R. 3 W

Well No. # 2 Johnson Farm

T. A. Phillips & Sanderson Company


Melland Contractor

330 Ft. from N. Line

Ft. from S. Line

330 Ft. from E. Line

Ft. from W. Line

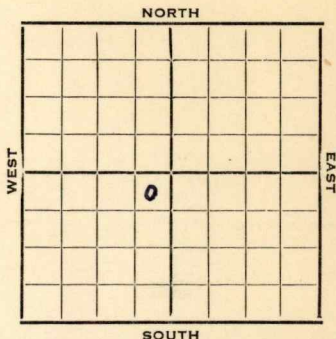

NE NE SW

1953

Elev. 1317' REPORT

4/8

Spud 4-4-53
8" @ 325

4/16

Drlg. 3000'

4/23

Miss 2862' **Mq 3385'** TD 3389
5" @ ?

4/30

5" @ 3386 CO 3389 1000 A
S/4 BOPH 7 hrs.

5/7

NR

5/21

NR

5/27

Spud 4-4-53
Oil Well
TD 3389
8" @ 325'
Miss 2862, Maq. 3385,
TD 3389
5" @ 3386'
CO to 3389 1000 A S/4 boph
Comp. 107 bopd 2% wtr.

COMPLETED

County Saline State Kansas
 Sec. 5 (Blk.) 16 (Sur.) 3W Map No.
 (Twp.) (Rge.)
 Operator T. A. Phillips & Sanderson
 Well No. 2 Farm Johnson
 Elev. 1317 Location NE NE SW

COMPLETE									

330 Ft. From N Line SW
330 Ft. From E Line Quarter
 1st. Report
 Completion MAY 27 1953
 Remarks Melland - Contr.
 Spudding Date 4-4-53

Drlg. Data Oil well TD 3389
8" @ 325 Miss. 2862 Maq. 3385
TD 3389 5" @ 3386 CO to 3389 1000 A
S/ 4 boph Comp. 107 bopd 2% wtr.