


KANSAS

Section 23 Township 14 Range 13W

Well No. #1 Bond

Company Frank Woods

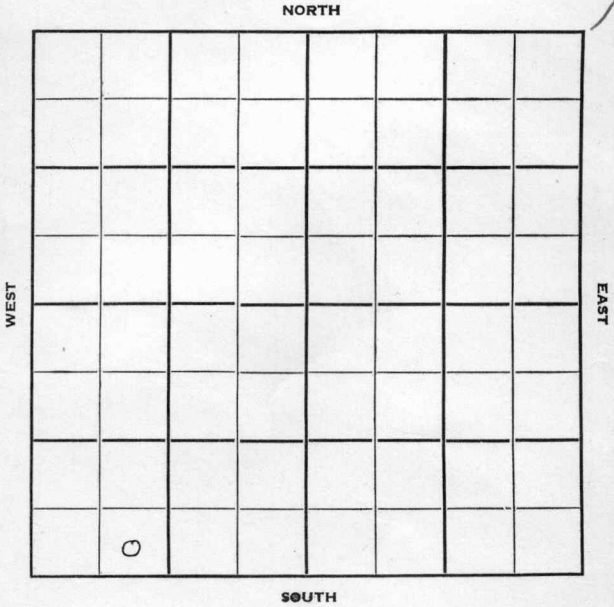

Sec. 23 Twp. 14 R. 13 W

Well No. # 1 Bond Farm

Frank Woods Company


Contractor

**Hall-Burney Pool**

Ft. from N. Line

NORTH

330 Ft. from S. Line

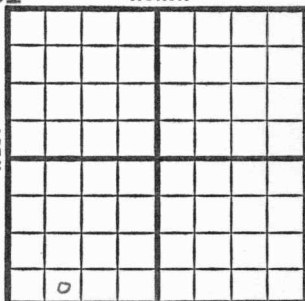

Ft. from E. Line

990 Ft. from W. Line

SE SW SW

MCPC has NW/4 of 26

SOUTH

1951

Elev. 1745 REPORT

9/6

RUCT

9/10

Rigging up cable tools

9/14

Rigging up.

(L R)

9/21

Spudded 9-15-51

Drilling 260'.

"

9/27

10" at 378'

8" at 673'

Drilling 820'.

"

10/24

Spud 9-15-51

Oil Well TD 2256

10" @ 378

8" @ 673

Anhy 670 Tarkio 2248

5" @ 2253 TD 2256 FU 1200'

oil 10 hr.

Comp. 40 BOPD

**COMPLETED**

County Russell State Kansas

Sec. 23 (Blk. 14) (Sur. 13W) (Twp.) (Rge.) Map No.

Operator Frank Woods

Well No. 1 Farm Bond

Elev. \_\_\_\_\_ Location SE SW SW/4



1330 Ft. From S Line SW

990 Ft. From W Line Quarter

1st. Report SEP 5 1951

Completion \_\_\_\_\_

Remarks \_\_\_\_\_

Spudding Date \_\_\_\_\_

Drig. Data MCPC has NW/4 of 26 Hall-Gurney Pool

**R U C T**

