


Section 6 Township 16 Range 3W

Well No. #1 Oleen

Company Bay Pet.

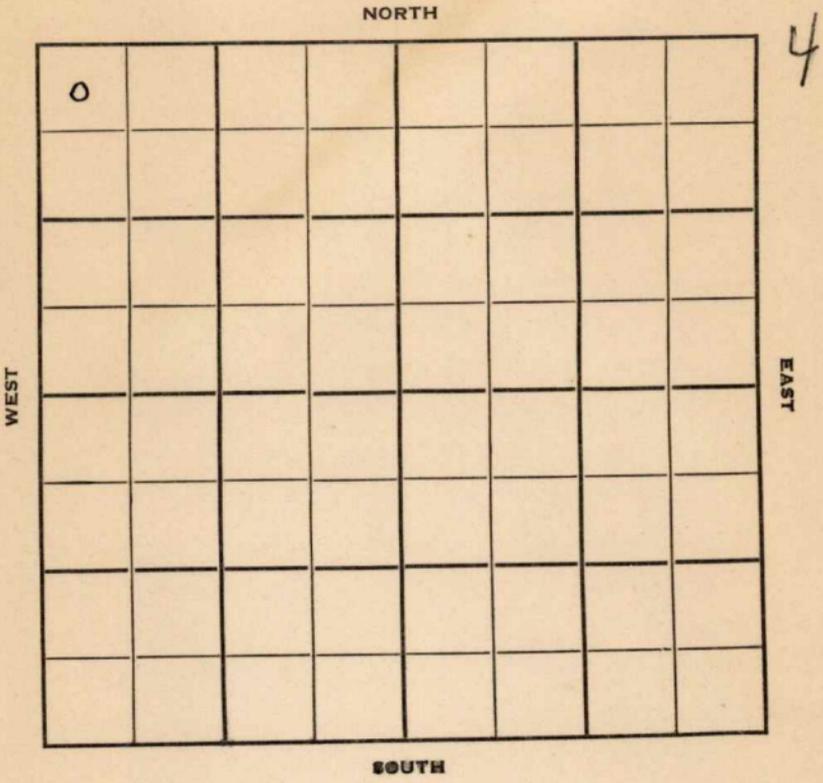

Saline

KANSAS

Sec. 6 Twp. 16 R. 3 W ✓

Well No. # 1 Oleen Farm

Bay Petroleum Company

Contractor

Smolan Pool


330 Ft. from N. Line

_____ Ft. from S. Line

_____ Ft. from E. Line

330 Ft. from W. Line

NW NW NW

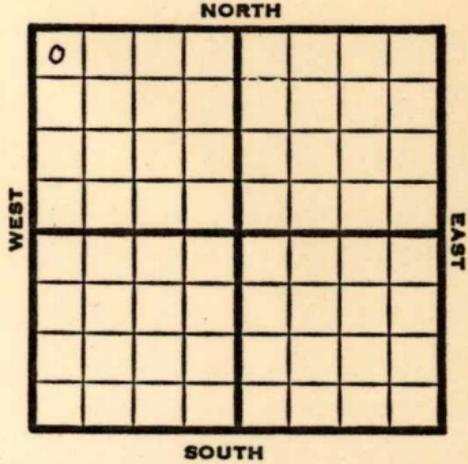

1951

Elev. 1307' REPORT

8/8 Location

8/22 Abandoned location

ABANDONED

County **Saline** State **Kansas**

Sec. **6** (Blk.) **16** (Sur.) **3W** Map No.

Operator **Bay Pet.**

Well No. **1** Farm **Oleen**

Elev. **1307** Location **NW NW NW**

| | | | | | |
|---------------------|--|--|--|--|--|
| 0 | | | | | |
| FIRST REPORT | | | | | |
| | | | | | |
| | | | | | |
| | | | | | |
| | | | | | |

330 Ft. From **N** Line **NW**

330 Ft. From **W** Line **Quarter**

1st. Report **AUG 8 1951**

Completion

Remarks

Spudding Date

Drlg. Data **Smolan Pool**

Location

J. E. TYRA

County Saline State Kansas

Sec. 6 (^{Blk.} ^{Twp.}) 16 (^{Sur.} ^{Rge.}) 3W Map No.

Operator Bay Pet.

Well No. 1 Farm Oleen

Elev. 1307 Location NW NW NW

| | | | | | |
|---|--|--|--|--|--|
| 0 | | | | | |
| | | | | | |
| | | | | | |
| | | | | | |
| | | | | | |
| | | | | | |
| | | | | | |
| | | | | | |
| | | | | | |
| | | | | | |

330 Ft. From N Line NW

330 Ft. From W Line Quarter

1st. Report

Completion AUG 22 1951

Remarks Smolan Pool

Spudding Date

ABANDONED

Drig. Data

Abd. location