

Section 5 Township 16 Range 3 WWell No. # 1 JohnsonCompany ~~E. K. Carey~~ Phillips & ~~STANDERSON~~

0							

NORTH

WEST

EAST

SOUTH

13

Saline KANSAS



Sec. 5 Twp. 16 R. 3 W

Well No. # 1 Johnson Farm

Phillips & Sanderson
E. K. Carey

Company

Contractor

Wildcat


Ft. from N. Line

330 Ft. from S. Line

Ft. from E. Line

330 Ft. from W. Line

SW SW SW

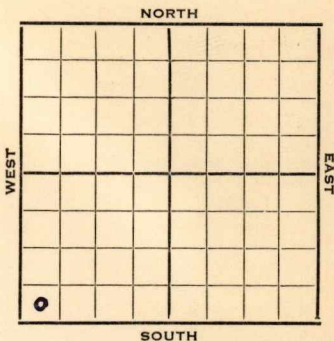

1952 Elev. 1346' REPORT

9/4 Location

9/10 8" @ 355
Drlg. 1950'

9/17 KC 2278' Miss 2910'
Drlg. 3355'

9/24 Hunton 3350' Mq shale 3381'
Maq Dol 3435-43' RTD
DST 3436-43, 1 hr, 120' SO & GCM
60' HO & GCM 1200# 15" 4" @ 3436
CO 3443' Fill up 1475' oil 12 hrs.
S/3 BOPH for 4 hrs. 500 A S/4 BOPH
for 4 hrs.

10/1 S/28 BO 8 hrs 1% wtr. POP

10/8 "

10/15 "

10/22 NR

10/29 "

11/5 "

11/12 Spud 9-3-52 Oil well TD 3443'
8" @ 355 KC 2278' Miss 2910'
Hunton 3350' Maq sh. 3381' Maq
dol. 3435' TD 3443'
DST 3436-43, open 1 hr. rec 120' SO
& GCM, 120' O & GCM, 60' HO & GCM
1200# 4" @ 3436 CO to 3443'

OVER

1952

11/12

(Information continued)

FU 1475' oil 12 hr. S/3 BOPH

500 A S/4 BOPH S/28 BO 8 hr.

Comp. 120 BOPD 9% wtr.

COMPLETED

County Saline State Kansas
 Sec. 5 (Blk.) 16 (Sur.) 3W Map No.

Operator E. K. Carey

Well No. 1 Farm Johnson

Elev. Location SW SW SW

FIRST REPORT

0

330 Ft. From S Line SW

330 Ft. From W Line Quarter

1st. Report SEP 4 1952

Completion

Remarks

Spudding Date

Drilg. Data Wildcat

Location

Saline

Kansas

Map No. _____ Sec. 5 Twp. 16 R. 3W

Well No. 1 Johnson

Phillips & Sanderson

Company

Contractor

SW SW SW

SECTION PLAT

0			

_____ Ft. from N. Line

330 Ft. from S. Line

_____ Ft. from E. Line

330 Ft. from W. Line

CORRECTION

Location _____

Rig up _____

Drilling and Remarks:

Reported

E. K. Carey

RECORD

Cased _____ in., _____ ft.

Sand _____

Gas _____

Oil _____

Total Depth _____

PRODUCTION

1st 24 hrs. Nat. _____

1st 24 hrs. after shot _____

Gas _____ Cu. Ft.

Dry Hole _____

Abandoned _____

Date

SEP 10 1952

J. G. McGEHEE

19

Scout

County Saline State Kansas
 Sec. 5 (Blk. 16) (Sur. 3W) Map No. _____
 Operator Phillips & Sanderson
 Well No. 1 Farm Johnson
 Elev. 1346 Location SW SW SW



330 Ft. From S Line SW
330 Ft. From W Line Quarter
 Ist. Report _____
 Completion NOV 12 1952
 Remarks Wildcat

0
 Drlg. Data Oil well TD 3443
9-3-52

8" @ 355 KC 2278 Miss. 2910

Hunton 3350 Mag. sh. 3381 Mag. dol. 3435

TD 3443 DST 3436-43 open 1 hr.

Rec. 120' so & gcm 120' o & gcm

60' ho & gcm 1200# 4" @ 3436 CO to

3443 \ FU 1475' oil 12 hr. S/ 3 boph

500 A S/ 4 boph S/ 28 bo 8 hr.

Comp. 120 bopd 9% wtr.