FORM 51

Russell KANSAS

Section 23 Township 14 Range 13 W

Well No. # 1 Steinle

Company Murfin Drlg.

2

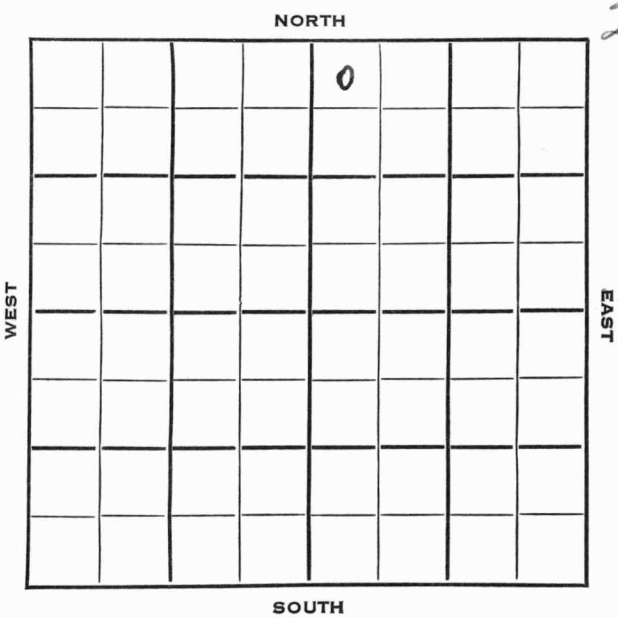

FORM 252-B

Russell

KANSAS

Sec. 23 Twp. 14 R. 13W

Well No. #1 Steinle Farm

Murfin Drlg. Company

Murfin Drlg. Contractor

Hall-Gurney

330 Ft. from N. Line

Ft. from S. Line

Ft. from E. Line

330 Ft. from W. Line

NW NW NE

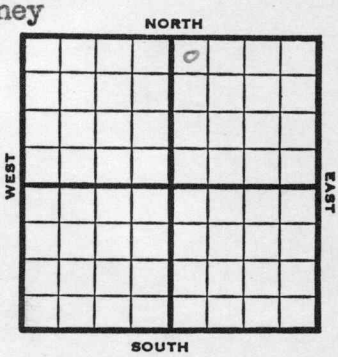

1953	Elev. 1789' REPORT
6/3	Loc.
6/10	"
6/24	"
7/1	"
7/8	10" @ 313' Anhy 742' 8" @ 750' P TD 830'
7/22	Drlg. 2230'
7/29	Spud 6-28-53 D & A TD 2375 10" @ 313 Anhy 742 8" @ 750 Tarkio 2307 TD 2375 D & A ABANDONED

FORM 275 FOR SALE BY KANSAS BLUE PRINT CO.

County Russell State Kansas

Sec. 23 (Blk. Twp.) 14 (Sur. Rge.) 13W Map No.

Operator Murfin Drlg.

Well No. 1 Farm Steinle

Elev. Location NW NW NE

330 Ft. From N Line NE

330 Ft. From W Line Quarter

1st. Report JUN 3 1953

Completion

Remarks

Murfin Drlg. - Contr.

Spudding Date

Hall-Gurney Pool

Drlg. Data

Location

J. G. McGEHEE

FORM 275 FOR SALE BY KANSAS BLUE PRINT CO.

County Russell State Kansas

Sec. 23 (Blk. Twp.) 14 (Sur. Rge.) 13W Map No.

Operator Murfin Drlg.

Well No. 1 Farm Steinle

Elev. 1789 Location NW NW NE

330 Ft. From N Line NE

330 Ft. From W Line Quarter

1st. Report

Completion JUL 29 1953

Remarks Hall-Gurney Pool

Murfin Drlg. - Contr.

Spudding Date 6-28-53

Drlg. Data D & A TD 2375

10" @ 313 Anhy 742 8" @ 750

Tarkio 2307 TD 2375

D & A

J. G. McGEHEE