


KANSAS

Saline

Section 5 Township 16 Range 3W

Well No. 1 LeAnder

Company Butler & White

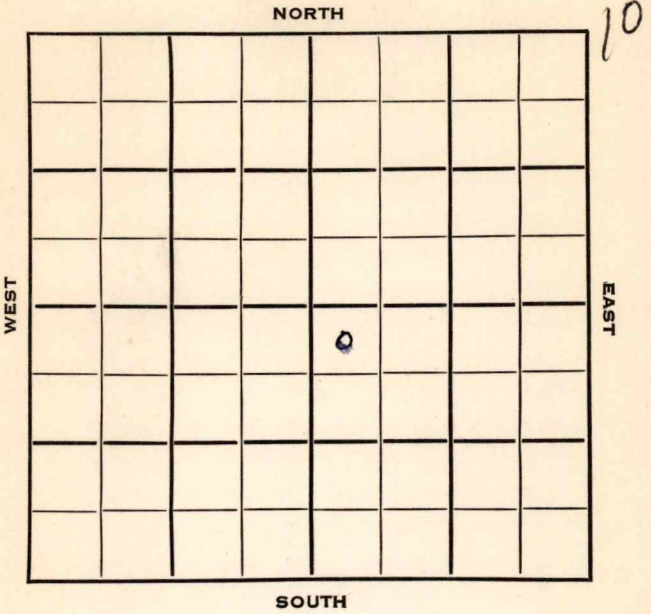

Sec. 5 Twp. 16 R. 3 W

Well No. # 1 LeAnder Farm

Butler & White Company

Contractor

Salemburg Pool

330

Ft. from N. Line


Ft. from S. Line

Ft. from E. Line

330

Ft. from W. Line

NW NW SE

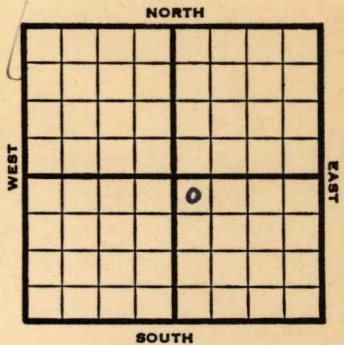

1952 **Elev. 1312** REPORT

12/17 Spud 12-11-52
12" @ 265
Drlg. 1655'

12/25 Drlg. 1655

1/1 Miss 2842 RH 3128 Mg shale 3293 Dol 3364 RTD 3372 4" @ 3365
CO 3372 FU 350' Oil 16 Hrs. 500A

1/22 FU 1080' oil 16 hrs.

1/29 P/27 BO 8 hrs.

2/5 NR

2/12 NR

2/18 Spudding Date 12/11/52
Oil Well TD 3372
12" @ 265 **Miss. 2842 Kh. 3128, Maq. sh. 3293 Maq dol 3364** TD 3372
4" @ 3365 CO to 3372 FU 350' oil 16 hr. 500 A FU 1080' ol 16 hr.
P/27 bo 8 hr. Comp. 112 bopd 1% wtr.

COMPLETED

County **Saline** State **Kansas**

Sec. **5** (Blk. Twp.) **16** (Sur. Rge.) **3W** Map No.

Operator **Butler & White**

Well No. **1** Farm **LeAnder**

Elev. Location **NW NW SE**

330 Ft. From **N** Line **SE**

330 Ft. From **W** Line Quarter

Ist. Report **DEC 17 1952**

Completion

Remarks

Spudding Date **12-11-52**

Drlg. Data **Salemburg Pool**

12" @ 265 drlg. 1655

County Saline State Kansas

Sec. 5 (Blk. 16) (Sur. 3W) Map No.

Operator Butler & White

Well No. 1 Farm LeAnder

Elev. 1312 Location NW NW SE

330 Ft. From N Line SE

330 Ft. From W Line Quarter

1st. Report

Completion FEB 18 1953

Remarks Salemburg Pool

Spudding Date 12-11-52

Drlg. Data Oil well TD 3372

12" @ 265 Miss. 2842 Kh. 3128

Maq. sh. 3293 Maq. dol. 3364 TD 3372

4" @ 3365 CO to 3372 FU 350' oil 16 hr.

500 A FU 1080' oil 16 hr.

P/ 27 bo 8 hr. Comp. 112 bopd 1% wtr.