


Section 23 Township 14 Range 13W

Well No. #4 Bond

Company Duke & Wood

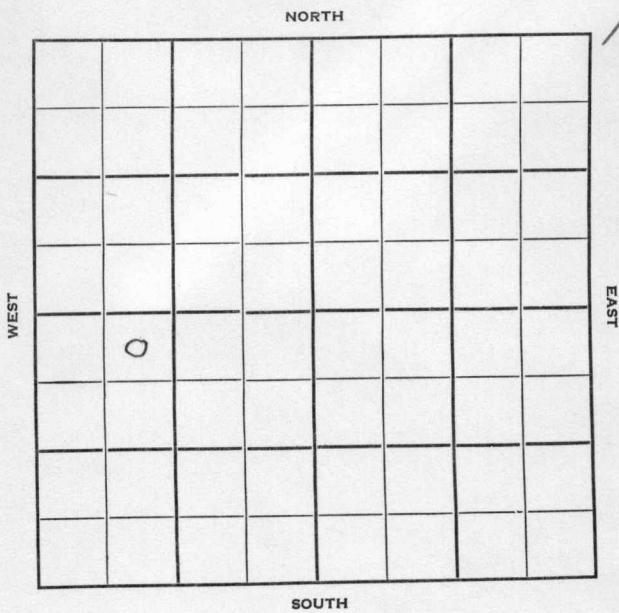

Sec. 23

Twp.

14

R.

13W

Well No. #4 Bond

Farm

Duke & Wood

Company

Duke & Wood - Contr.

Contractor

Hall Gurney


330' Ft. from N. Line

Ft. from S. Line

Ft. from E. Line

990' Ft. from W. Line

NE NW SW

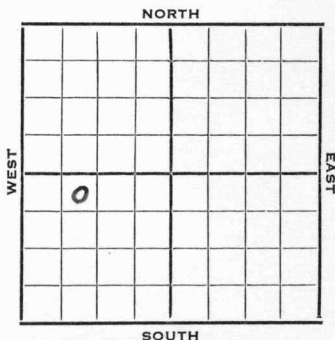

1952

Elev. 1771'

REPORT

9/17 RU
 9/24 8" @ 226 Tarkio 2276' RTD 2300
 4" @ 2298
 10/1 NR
 10/8 Drlg. deeper to 2310' TD
 B/12 goph Sd-frac
 10/15 PB 2292
 38/2277-82, S/1 1/2 BOPH Sd-frac
 10/22 Spud 9-16-52
 Oil Well
 TD 2310'
 8" @ 226'
 Tarkio 2276'
 TD 2300'
 4" @ 2298
 DD 2310 B/12 goph sd-fraac
 S/5 boph PB 2292' 38/2277-82'
 S/1 1/2 boph sd-frac 6 boph CO to 2301
 S/10 boph 8 hr.
 Comp. 25 bopd

COMPLETED

County **Russell** State **Kansas**

Sec. **23** (Blk. Twp.) **14** (Sur. Rge.) **13W** Map No.

Operator **Duke & Wood**

Well No. **4** Farm **Bond**

Elev. Location **NE NW SW**

330 Ft. From **N** Line **SW**
990 Ft. From **W** Line Quarter

1st. Report **SEP 17 1952**

Completion

Remarks

Duke & Wood - Contr.

Spudding Date

Hall Gurney

Drig. Data

RV

J. G. McGEHEE

