

FORM 51

Russell

KANSAS

Section 23 Township 14 Range 13W

Well No. 5 Bond

Company Duke & Wood

NORTH

12

SOUTH

WEST


EAST

0

Russell KANSAS ✓

Sec. 23 Twp. 14 R. 13 WWell No. # 5 Bond FarmDuke & Wood CompanyDuke & Wood Contractor990 Ft. from N. Line Ft. from S. Line Ft. from E. Line990 Ft. from W. Line

SE NW SW

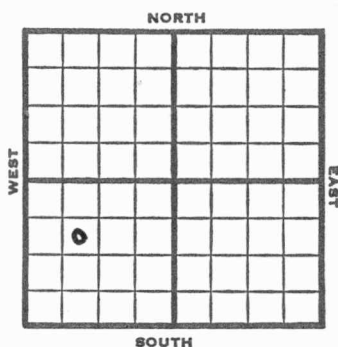

1953 Elev. 1765' REPORT

2/11 Spud 2-5-53
8" @ 232 Anhy 703
Drlg. 2268

2/19 Tarkio 2272 Heeb 2837' Lans 2906
Drlg. 3060'

2/26 DST 2910-32, 3/4 hr, 60' M plus VSSO
350#
DST 3941-55, 40 mins, 10' M
DST 3087-98, 3/4 hr, 9' M plus VSSO
300# Cong 3200' Arb. 3205'
RTD 3207' 5" @ 3206

3/12 Testing

3/19 "

3/26 "

4/1 Spud 2-5-53
Oil Well
TD 3211
8" @ 232
Anhy 703, Tarkio 2272, Heeb 2837,
Lans. 2906
DST 2910-32 open 3/4 hr. Rec 60' mud
& VSSO 350#
DST 2941-55 open 40 min. Rec 10' mud
0#
DST 3087-98 open 3/4 hr. Rec 9' mud
& VSSO 300#

OVER

1953

-Information-brought forward

4/1

Cong 3200, Arb 3205

TD 3207

5" @ 3206

DD 3211 wtr.

SP 3160 24/ 3133-38 500A dry 30/

2367/71 FU 100' oil 1600' wtr

12 hr. PB 2323 12/2290-92 24/

2269-71

hydro. S/ 2 boph 4 hr.

Comp. 25 bopd.

COMPLETED

County Russell State Kansas

Sec. 23 (Blk. Twp.) 14 (Sur. Rge.) 13W Map No.

Operator Duke & Wood

Well No. 5 Farm Bond

[illegible]


990 Ft. From N Line SW

990 Ft. From  Line Quarter

1st. Report FEB 11 1953

Completion _____

Remarks

Duke & Wood - Contr.


Spudding Date 2-5-53

Drlg. Data

8" @ 232 Anhy 703 drlg. 2268

J. G. McGEHEE

County Russell State Kansas
 Sec. 23 (Blk.) 14 (Sur.) 13W Map No.
 Operator Duke & Wood
 Well No. 5 Farm Bond
 Elev. 1765 Location SE NW SW

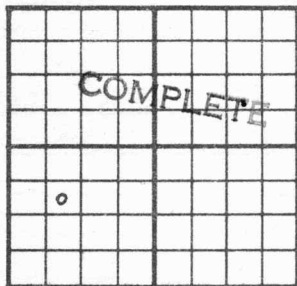

990 Ft. From N Line SW
990 Ft. From W Line Quarter
 1st. Report
 Completion APR 1 1953
 Remarks
Duke & Wood - Contr.
 Spudding Date 2-5-53

Drig. Data Oil well TD 3211
8" @ 232 Anhy 703 Tarkio 2272
Heeb. 2837 Lans. 2906 DST 2910-32
open 3/4 hr. Rec. 60' mud & VSSO 350#
DST 2941-55 open 40 min. Rec. 10' mud
0# DST 3087-98 open 3/4 hr. Rec. 9' mu
& VSSO 300# Cong. 3200 Arb. 3205
TD 3207 5" @ 3206 DD 3211 wtr. SP 3160
24/ 3133-38 500 A dry 30/ 2367-71
FU 100' oil 1600' wtr. 12 hr.
PB 2323 12/ 2290-92 24/ 2269-71
Hydro. S/ 2 boph 4 hr.
Comp. 25 bopd

J. G. McGENEE