


Section 20 Township 16 Range 1 W

Well No. #3 Community Hunter

Company Deep Rock

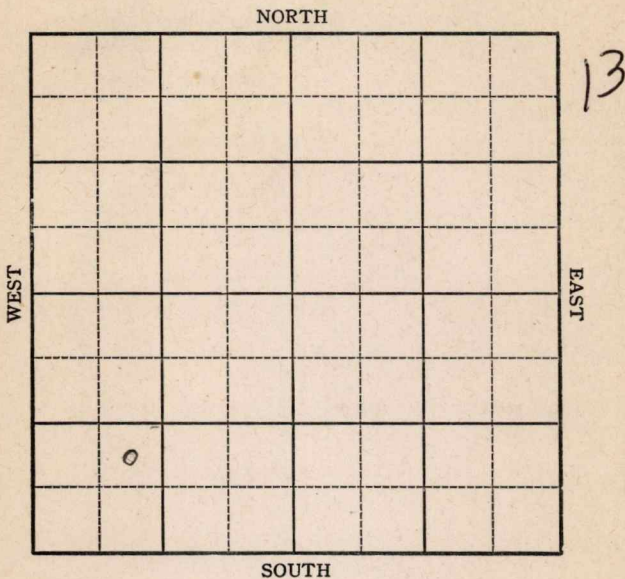


Sec. 20 Twp. 16 R. 1-W

Well No. #3 Community Hunter Farm

Deep Rock Company

NORTH

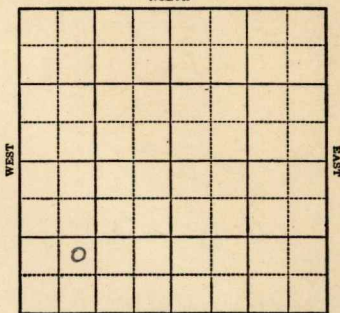

SOUTH

_____ Ft. from N. Line

990 Ft. from S. Line

_____ Ft. from E. Line

990 Ft. from W. Line

Elev. 1314

1943 R E P O R T

12/1	Cellar
12/8	10" @ 130 Drlg. 810
12-15	Miss 2653-55' TD Run csg.
12/22	7" @ 2649 Rust
12/29	TD 2656 1000 acid Temp Pot 73
1944	
1-5	" "
1-12	" "
1/19	" "
1/26	" "
2/2	" "
2/8	" "
2/16	7" @ 2649 Miss 2649 TD 2656 1000 acid Pump 256 oil & 1110 water Gravity 36

COMPLETED

KANSAS
Map No. 42 Sec. 20 Twp. 16 R. 1W

Well No. 3 Community Hunter

Deep Rock Company

FIRST REPORT

Contractor

NE SW SW

SECTION PLAT

Ft. from N. Line

990 Ft. from S. Line

Ft. from E. Line

990 Ft. from W. Line

Hunter Pool

Location _____

Rig up _____

Drilling and Remarks:

Cellar

RECORD

Cased _____ in., _____ ft.

Sand _____

Gas _____

Oil _____

Total Depth _____

PRODUCTION

1st 24 hrs. Nat. _____

1st 24 hrs. after shot _____

Gas _____ Cu. Ft.

Dry Hole _____

Abandoned _____

Date

DEC 1 1943 19

S. J. LEWIS Scout

KANSAS

Map No. 42 Sec. 20 Twp. 16 R. 1W

Well No. 3 Community Hunter

Deep Rock Company

COMPLETED Contractor

NE SW SW

SECTION PLAT

_____ Ft. from N. Line

990 Ft. from S. Line

_____ Ft. from E. Line

990 Ft. from W. Line

Hunter Pool

Location _____

Rig up _____

Drilling and Remarks:

*Miss 2649
 7" @ 2649.
 100 acid
 Pump 256 oil +
 110 Water
 86 ⁰/₁₀₀*

RECORD

Cased _____ in., _____ ft.

Sand _____

Gas _____

Oil _____

Total Depth 2656

PRODUCTION

1st 24 hrs. Nat. _____

1st 24 hrs. after shot _____

Gas _____ Cu. Ft.

Dry Hole _____

Abandoned _____

Date

FEB 16 1944 19

S. J. LEWIS Scout