


Section 1 Township 16 Range 14-W

Well No. 1 Hoffman "C"

Company Shell

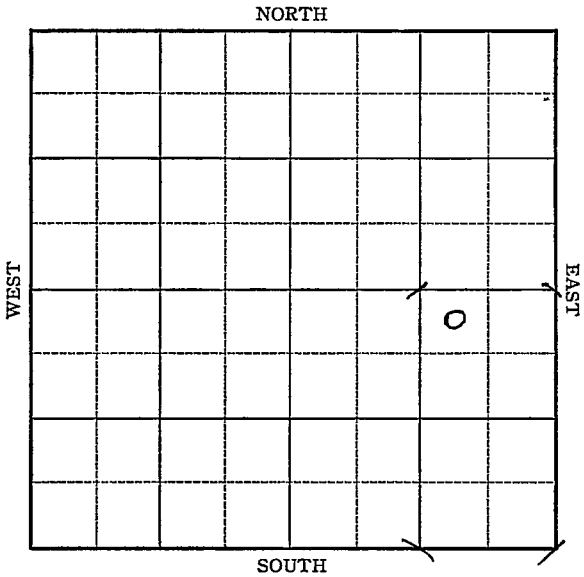

Sec. 1 Twp. 16 R. 14-W

Well No. #1 Hoffman "C" Farm

Shell Company


330 Ft. from N. Line

_____ Ft. from S. Line

1030 Ft. from E. Line

_____ Ft. from W. Line

Elev. 1884'

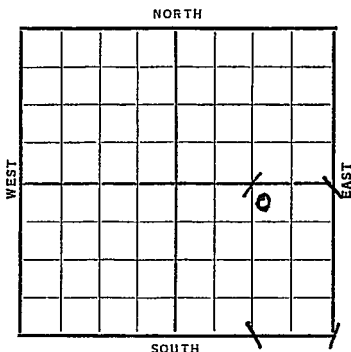

W.S.S.

Date	REPORT
1938	
1/19	B.R.R.
1/28	10" - 644' Drlg. 700'
2/4	Drlg. 2405'
2/11	Arb. 3312'. Sm. S.O. Coring.
2/18	7" @ 3312'. T.D. 3326'. 1800' oil in 13 hrs. Swab 116 oil in 6 hrs.
2/26	4000 acid. Deepened to 3336' TD Swab 357 oil in 12 hrs.
3/4	TD 3336' SD.
3/11	" "
3/18	" "
3/25	4000 acid.
OVER	

1938

3/30

7" @ 3312'

Arb. 3312'

T.D. 3336'

8000 acid.

Potential 1591 bbls.

COMPLETED



Barton KANSASMap No. 73 Sec. 1 Twp. 16 R. 14W,Well No. 1 Hoffman "C"Shell Company

Contractor

FIRST REPORT

NW NE SE

330 Ft. from N. Line

_____ Ft. from S. Line

1030 Ft. from E. Line

_____ Ft. from W. Line

SECTION PLAT

			0

Location _____

Rig up _____

Drilling and Remarks:

BRR

RECORD

Cased _____ in., _____ ft.

Sand _____

Gas _____

Oil _____

Total Depth _____ in.

PRODUCTION

1st 24 hrs. Nat. _____

1st 24 hrs. after shot _____

Gas _____ Cu. Ft.

Dry Hole _____

Abandoned _____

Date

JAN 19 1938 19H. D. Hatfield Scout

Map No. 73 Sec. 1 Twp. 16 R. 14W

Well No. 1 Hoffman "C"

Shell Company

Contractor

COMPLETED

SECTION PLAT

330 NW NE SE
Ft. from N. Line

_____ Ft. from S. Line

1030 Ft. from E. Line

_____ Ft. from W. Line

			0

Location _____

Rig up _____

Drilling and Remarks:

8000 acid
POT 1591

RECORD

Cased 7 in., 3312 ft.

Sand Ark 3312

Gas _____

Oil _____

Total Depth 3336

PRODUCTION

1st 24 hrs. Nat. _____

1st 24 hrs. after shot _____

Gas _____ Cu. Ft.

Dry Hole _____

Abandoned _____

Date

MAR 30 1938 19

H. D. Hatfield Scout