


Section 23 Township 14 Range 13W

Well No. 2 Bond "B"

Company Duke & Wood

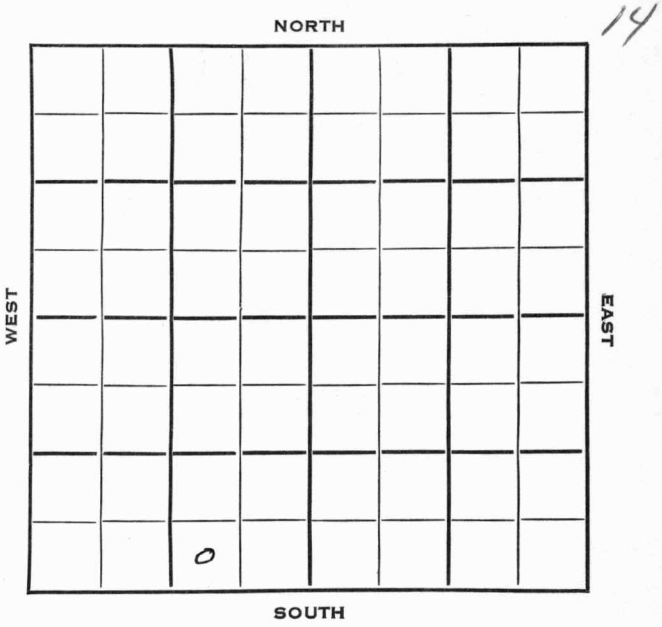

Russell

KANSAS ✓

Sec. 23 Twp. 14 R. 13W

Well No. 2 Bond "B" Farm

Duke & Wood Company

Duke & Wood Contr. Contractor


Ft. from N. Line

330 Ft. from S. Line

990 Ft. from E. Line

Ft. from W. Line

SW SE SW

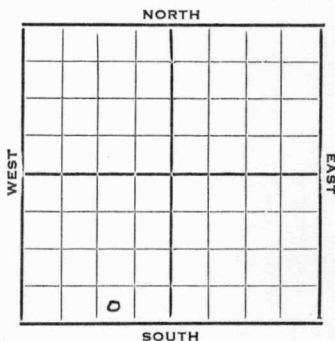

1953 Elev. 1738 REPORT

1/7	Spudding Date 1/1/53 8" @ 230 Anhy 661 Drlg. 1791
1/22	1st Tarkio 2237' 2nd Tarkio 2259' 5" @ 2297 RTD 2297'
1/29	NR
2/5	NR
2/12	NR
2/19	NR
2/26	NR
3/12	NR
3/19	NR
3/26	NR
4/2	"
4/9	Testing
4/15	Spud 1-1-53 Oil Well TD 2297 8" @ 230 Anhy 661, 1st Tarkio 2237, 2nd Tarkio 2259 5" @ 2297, CO to 2277, 11/2262-64, 15/2238-40 S <sup>1</sup> / <sub>2</sub> goph, 10 hrs., sd-oil-frac S <sup>1</sup> / <sub>6</sub> boph 4 hrs., FU 1350' oil, 250' wtr., 12 hrs. Comp 75 bopd

**COMPLETED**



