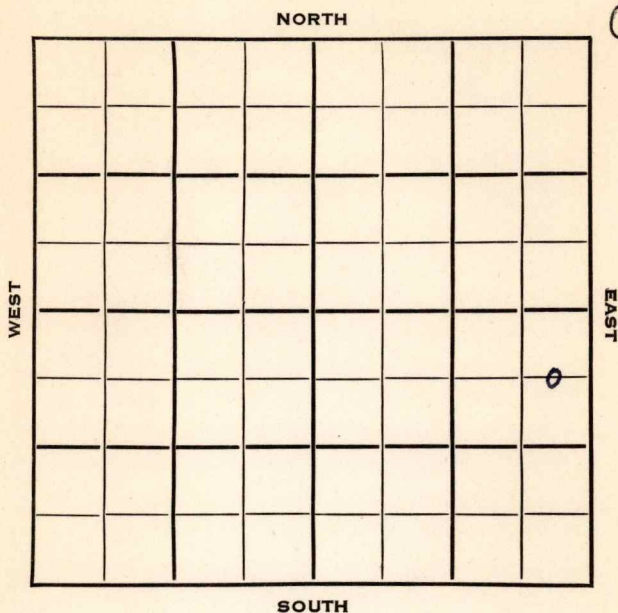


Section 7 Township 16 Range 3WWell No. #1 Anderson-GrothausCompany National Assoc. Petr.

Saline

KANSAS

Sec. 7 Twp. 16 R. 3WWell No. #1 Anderson-Grothaus FarmNational Assoc. Pet. CompanyNational Assoc. Contractor

Salemborg Pool


660 Ft. from N. Line

Ft. from S. Line

330 Ft. from E. Line

Ft. from W. Line

C E L N E S E

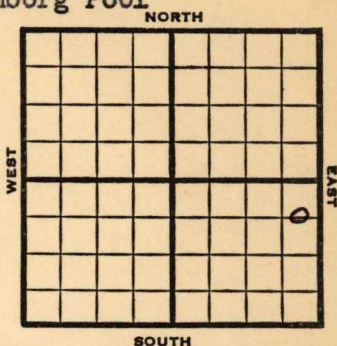

1953

Elev. 1368'

REPORT

7/22

Spud 7-18-53

10" @ 150'

Drlg 2500'

7/29

Lans 2315, Miss 2938, KH 3228, Mq
dol 3462

RTD 3466

5" @ 3462

8/5

Spud 7-18-53

D&A

TD 3466

10" @ 150

Lans 2315, Miss 2938, Kh. 3228, Maq.
3462

TD 3466

5" @ 3462

CO to 3466, 500A, S/1½ ~~hwp~~ go 32 gwph

D&A

ABANDONED

J. G. McGEHEE

County Saline State Kansas
 Sec. 7 (Blk. 16) (Sur. 3W) (Twp.) Map No.
 Operator National Assoc. Pet.
 Well No. 1 Farm Anderson-Grothaus
 Elev. 1368 Location C E L NE SE



660Ft. From N Line SE
330Ft. From E Line Quarter

1st. Report

Completion 406 5 1953

Remarks Salemborg Pool

Nat'l Assoc. - Contr.

Spudding Date 7-18-53

Drlg. Data D & A TD 3466

10" @ 150 Lans. 2315 Miss. 2938

Kh. 3228 Maq. 3462 TD 3466 5" @ 3462

CO to 3466 500 A S/ 1½ go 32 gwph

D & A