


Section 23 Township 14 Range 13 W

Well No. # 3 Bond "B"

Company Duke & Wood

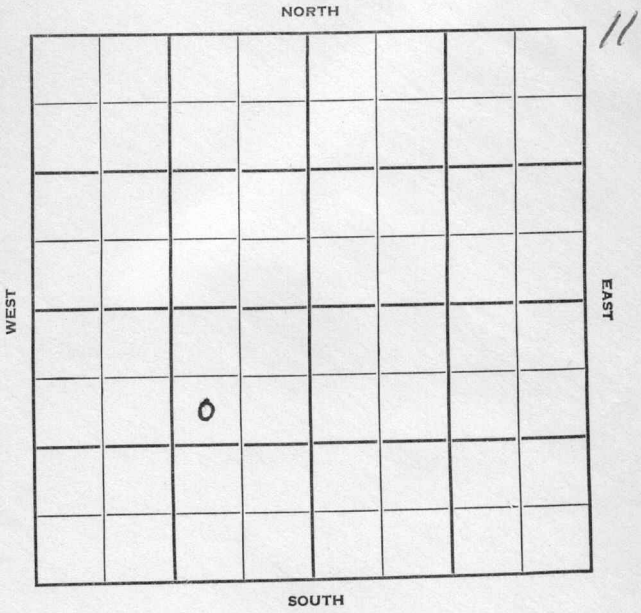

Sec. 23 Twp. 14 R. 13W

Well No. #3 Bond "B" Farm \_\_\_\_\_

Duke & Wood Company \_\_\_\_\_

Duke & Wood Contractor \_\_\_\_\_


Hall-Gurney Pool

990 Ft. from N. Line

\_\_\_\_\_ Ft. from S. Line

990 Ft. from E. Line

\_\_\_\_\_ Ft. from W. Line

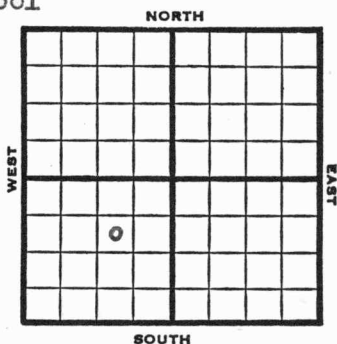

SWNE SW

1953 Elev. 1755' REPORT

- 4/15 Spud 4-8-53  
8" @ 226'  
Anhy 686  
Cored 2256-64, 7 1/2' Rec.  
Cored 2275-87
- 4/23 Tarkio 2268,  
RTD 2310  
5" @ 2310'
- 4/30 NR
- 5/7 Fish swab.
- 5/13 Spud 4-8-53  
Oil Well  
TD 2310'  
8" @ 226'  
Anhy 686, Tarkio 2268,  
TD 2310'  
5" @ 2310'  
23/ 2279-83 15 gm & wtr.  
20/ 2256-60 2/ 2063-64 S/ 1/2 boph  
FU 300' oil 12 hr. sd-frac.  
FU 1400' oil 100' wtr. 8 hr.  
S/ 17 boph  
Comp. 10 bopd.

COMPLETED

County Russell State Kansas

Sec. 23 (Blk. 14 (Sur. Rge.) 13W Map No.

Operator Duke & Wood

Well No. 3 Farm Bond "B"

Elev. \_\_\_\_\_ Location SW NE SW



990 Ft. From N Line SW

990 Ft. From E Line Quarter

1st. Report APR 15 1953

Completion \_\_\_\_\_

Remarks \_\_\_\_\_

Duke & Wood - Contr.

Spudding Date 4-8-53

Drig. Data Hall-Gurney Pool

8" @ 226 Anhy 686 Cored 2256-64

7 1/2' rec. Cored 2275-87

County Russell State Kansas

Sec. 23 (Blk. Twp.) 14 (Sur. Rge.) 13W Map No.

Operator Duke & Wood

Well No. 3 Farm Bond "B"

Elev. 1755 Location SW NE SW


**COMPLETE**

990 Ft. From N Line SW

990 Ft. From E Line Quarter

1st. Report

Completion MAY 13 1953

Remarks Hall-Gurney Pool  
Duke & Wood - Contr.

Spudding Date 4-8-53

Drig. Data Oil well TD 2310

8" @ 226 Anhy 686 Tarkio 2268

TD 2310 5" @ 2310 23/ 2279-83 15 gm

& wtr. 20/ 2256-60 2/ 2063-64

S/ 1/2 boph FU 300' oil 12 hr. sd-frac

FU 1400' oil 100' wtr. 8 hr.

S/ 17 boph Comp. 10 bopd