

Saline

KANSAS

Section 20 Township 16 Range 1WWell No. #3 E. TressinCompany Deep Rock

NORTH

2

				0			

SOUTH

WEST

EAST

Saline

KANSAS

 Sec. 20 Twp. 16 R. 1 W

 Well No. # 3 E. Tressin Farm

Deep Rock

Company

Flourney
Hunter Pool

Contractor

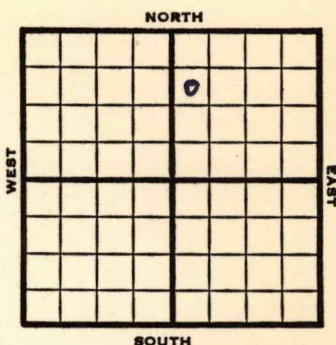
990 Ft. from N. Line

Ft. from S. Line

Ft. from E. Line

330 Ft. from W. Line

SW NW NE


 1953 **Elev. 1312'** REPORT

 2/18 **RUR**

 2/26 **Heeb 1809, Tor 1827, Doug 1841,**
6 1840-55, 15"
DST 1836-55, 1½ hrs., 130'
SOCM, 10' W
Br li 1965, Lans 2025
Drlg. 2060

3/12 "

 3/19 **NR**

 3/25 **Oil Well**

TD 3415

Heeb 1809, Tor 1827, Doug
1841
DST 1836-55, opn 1½ hrs., rec.
130' socm, 10' sw 0#
Br lime 1965, Lans 2025,
Miss 2616
DST 2620-31, opn ½ hrs., rec.
15' mud, VSS0, 620#
DST 2631-50, opn 1½ hrs., rec.
180' mud, 490' sul wtr., 790#
Kh 2868, Meianer 2975, Hunton
2992, Maq. 3074, Viola 3196,
Simp. 3283, Arb 3352

TD 3415

7" @ 3364

CO to 3415

OVER

#3 E. Tressin
(Information Brought Forward)

1953
3/25

24/1846-50, $1\frac{1}{2}$ boph 50% wtr.

500A

S/ $1\frac{1}{4}$ boph sd-dfrac

FU 250' wtr.

P/1 bf 6 mins., 75% wtr.

P/67 bo 74% wtr.

Comp. 65 bopd 150 bw

COMPLETED

County Saline State Kansas
 Sec. 20 (Blk.) 16 (Sur. Rge.) 1W Map No.
 Operator Deep Rock
 Well No. 3 Farm E. Tressin
 Elev. _____ Location SW NW NE

FIRST REPORT

990 Ft. From N Line NE330 Ft. From W Line Quarter1st. Report FEB 18 1953

Completion _____

Remarks _____

Flourney - Contr.

Spudding Date _____

Drlg. Data _____

Hunter PoolRUR

J. G. McGEHEE

