


Section 28 Township 16 Range 1 W

Well No. # 1 Karber

Company E. K. Carey

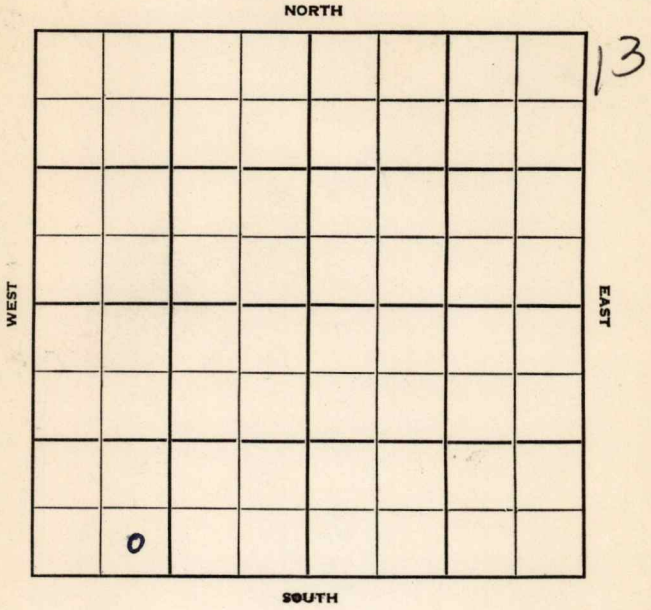




Sec. 28 Twp. 16 R. 1W

Well No. #1 Karber Farm
E. K. Carey Company
E. K. Carey - Contr. Contractor

Ft. from N. Line
330' Ft. from S. Line
Ft. from E. Line
990' Ft. from W. Line

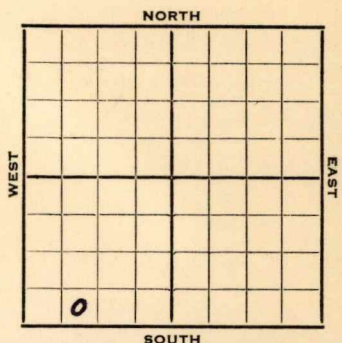

SE SW SW

1952 1277 RB 1274 IS REPORT

8/27 Spud 8-26-52
9/3 8" @ 120'
Lans. 1922' Miss. 2595'-2600' RTD
4" @ 2597'
9/10 DD 2618' TD S/3 BOPH 500 A
9/27 S/6 BOPH. POP
9/24 DD 2606' 5 gal Oil DD 2612'
B/98 gal 0 plus 31 Gal Water
S/1 BOPH 500 A S/13 BO 4 hrs.
DD 3618 wtr, S/6 BO 2 hrs. DD 2618'
S/21 BO 7 hrs. 500 A S/28 BO 5 hrs.
plus trace water.
10/1 NR
10/8 Spud 8-26-52
Oil Well TD 2618
8" @ 120'
Lans. 1922 Miss. 2595
TD 2600' 4" @ 2597 DD 2606
5 go DD 2612 B/98 go 31 gw
S/1 boph 500 A S/13 bo 4 hr.
DD 2616 Wtr. S/6 bo 2 hr.
DD 2618' S/21 bo 7 hr.
500 A S/28 bo 5 hr.
Comp. 150 bopd 50% wtr.

COMPLETED

