
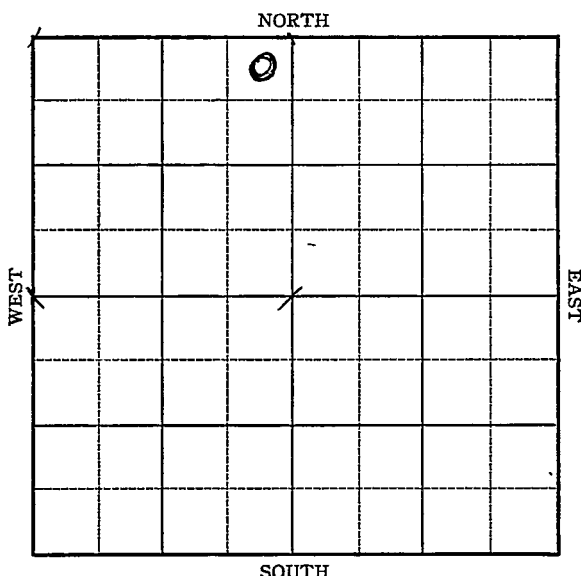


Section 1 Township 16 Range 14-WWell No. 1 - Schneider "B"Company Shell

Sec. 1 Twp. 16 R. 14-WWell No. #1 Schneider "B" FarmShell Company330 Ft. from N. Line       Ft. from S. Line330 Ft. from E. Line       Ft. from W. Line

Elev. 1844

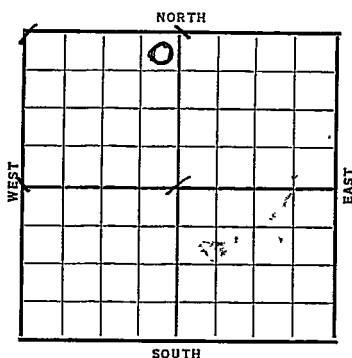

| Date  | REPORT                                     |
|-------|--------------------------------------------|
| 1937  |                                            |
| 9/15  | B.R.R.                                     |
| 9/24  | R. up.                                     |
| 10/2  | S. H.                                      |
| 10/8  | Drlg. 2280'.                               |
| 10/15 | 13" @ 655'. Topeka 2747'                   |
|       | No shows. K.C. 3050'.                      |
|       | Drlg. 3185'. No shows.                     |
| 10/22 | Sil. 3277'. T.D. 3281'.                    |
|       | Sat. Core. 7" @ 3278'.                     |
| 10/29 | T.D. 3291'. 4000 a cid.                    |
|       | Pump 150 bbls. oil & 15 bbls. water 4 hrs. |
| 11/5  | " " "                                      |
| 11/12 | " " "                                      |
| 11/19 | " " "                                      |
| 11/26 | " " "                                      |
| 12/3  | TD 3291' SD.                               |
| 12/10 | " " "                                      |
| 12/17 | SD for pipe line.                          |
| 12/24 | " " "                                      |

OVER

1937

12/31 TD 3291' SD.

1938.

1/7 " "

1/14 " "

1/20 " "

1/28 " "

2/4 " "

2/11 SD for pipe line.

2/18 " " "

2/26 " " "

3/4 " " "

3/11 " " "

3/18 " " "

3/25 " " "

4/1 " " "

4/8 " " "

4/13 7" @ 3278'.

Arb. 3277'.

T.D. 3291'.

4000 acid.

Potential 977 bbls.


**COMPLETED**

*Barton* KANSASMap No. \_\_\_\_\_ Sec. 1 Twp. 16 R. 14 WWell No. 1-Schneider "B"Shell Company

Contractor \_\_\_\_\_

## FIRST REPORT

## SECTION PLAT

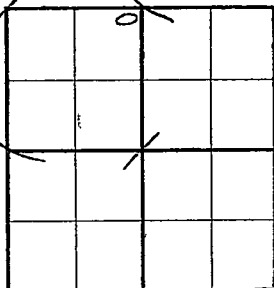330 Ft. from N. Line

\_\_\_\_\_ Ft. from S. Line

330 Ft. from E. Line

\_\_\_\_\_ Ft. from W. Line

Location \_\_\_\_\_

Rig up \_\_\_\_\_

Drilling and Remarks:

*B.R.R.*

## RECORD

Cased \_\_\_\_\_ in., \_\_\_\_\_ ft.

Sand \_\_\_\_\_

Gas \_\_\_\_\_

Oil \_\_\_\_\_

Total Depth \_\_\_\_\_

## PRODUCTION

1st 24 hrs. Nat. \_\_\_\_\_

1st 24 hrs. after shot \_\_\_\_\_

Gas \_\_\_\_\_ Cu. Ft.

Dry Hole \_\_\_\_\_

Abandoned \_\_\_\_\_

Date

SEP 15 1931 19

H. D. Hatfield

Scout

Barton KANSAS

Map No. 73 Sec. 1 Twp. 16 R. 14WWell No. 1 Schneider "B"Shell

Company

Contractor

**COMPLETED**

NE NW

330 Ft. from N. Line       Ft. from S. Line330 Ft. from E. Line       Ft. from W. Line**SECTION PLAT**

|  |   |  |  |
|--|---|--|--|
|  | 0 |  |  |
|  |   |  |  |
|  |   |  |  |
|  |   |  |  |

Location                     Rig up                     

Drilling and Remarks:

4000 andPOT 977**RECORD**Cased 7 in. 3278 ft.Sand Arb 3277Gas                     Oil                     Total Depth 3291**PRODUCTION**1st 24 hrs. Nat.                     1st 24 hrs. after shot                     Gas                      Cu. Ft.Dry Hole                     Abandoned                     

Date

APR 13 1938 19 H. D. Hatfield Scout