


DX 78-1

Section 20 Township 16 Range 1W

Well No. 5 Frank Norton

Company Deep Rock

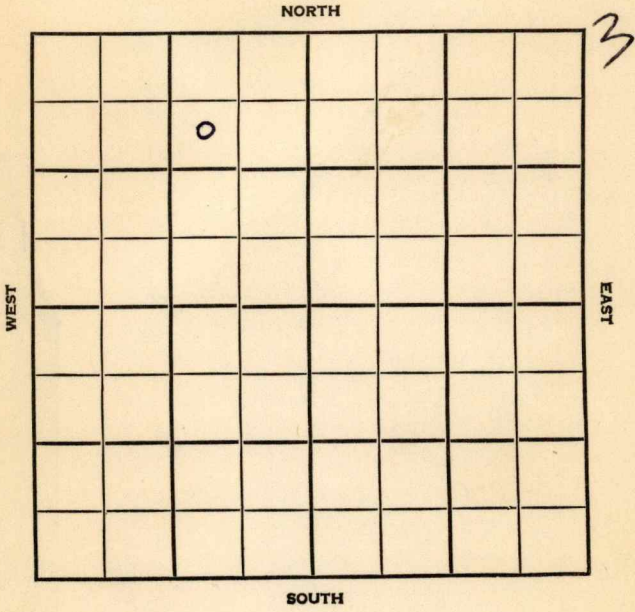



SEC. 20 TWP. 16 R. 1W

WELL NO. 5 Frank Norton FARM

COMPANY Deep Rock

CONTRACTOR Musgrove

964 Ft. from N. Line
 _____ Ft. from S. Line
 964 Ft. from E. Line
 _____ Ft. from W. Line

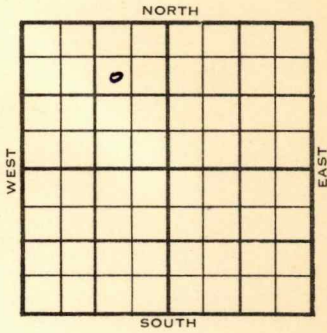

SW NE NW

	ELEVATION	REPORT
1954	1336'	

7/7 Spudding 7-3-54
 10" @ 134

7/28 WOC
 Spud 7-3-54 Oil well TD 1915'
 10" @ 134 Heeb 1837 Tor. 1855
 Doug. 1870 TD 1915 7" @ 1913
 CO to 1915 frac. S/4 BOPH 60% wtr.
 Comp. 34 BOPD 62% wtr.

COMPLETED

County Saline State Kansas

Sec. 20 (Blk.) 16 (Sur.) 1W Map No.

Operator Deep Rock

Well No. 5 Farm Frank Norton

Elev. _____ Location SW NE NW



964 Ft. From N Line NW

964 Ft. From E Line Quarter

Ist. Report JUL 7 1954

Completion _____

Remarks _____

Musgrove - Contr.

Spudding Date 7-3-54

Drlg. Data _____

10" @ 134 WOC

