

Saline


Form 51-5M-4-27-27423

Map No. **KANSAS** Sec. 21 Twp. 16 R. 1^W

Well No. 1 - Shred bed Farm

O.C. Bayne et al Company

NORTH

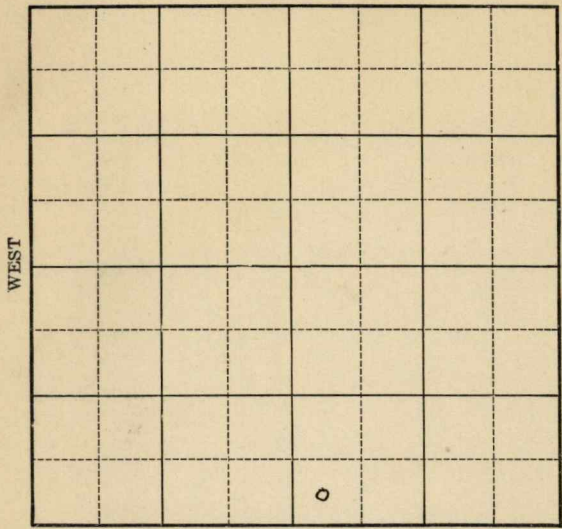

15

Location _____

Drilling Remarks _____

Rig Up _____

Drilling Remarks _____

RECORD

Cased _____ in. _____ ft.

Sand _____

Gas _____

Oil _____

Total Depth _____

PRODUCTION

1st 24 hrs. Nat. _____

1st 24 hrs. after shot _____

Gas _____ cu. ft.


Dry Hole _____

Abandoned _____

Map No. **KANSAS** Sec. 21 Twp. 16 R. 1 W

Well No. 1 - Thrul held Farm
C.A. Bayle et al Company

..... Ft. from N. Line
330 Ft. from S. Line
..... Ft. from E. Line
330 Ft. from W. Line

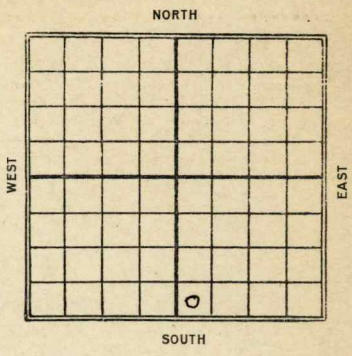

1928

Date	REPORT
9/19	Location
9/26	Rig
10/3	Spud
10/10	Drilg 600'
10/17	12 1/2" @ 1060 drilg.
10/24	Drilg 1485'
10/31	" 1800'
" 17	" 2040'
11/14	" 2205'
11/21	S.D. 2205' - T.D.
11/28	_____
12/5	run 6" - 2235'
12/12	Drilg 2310'
12/19	" 2600'
12/26	Top chat 2600 - T.D. 2615 - VIR 6"
1929	
1/2	VIR 6" - 2615' - T.D.
1/9	S.D. 2615'
1/16	fsq tools & 6" pipe - 2615'
1/23	_____
1/30	_____

2/6 - fsg tools & 6" pipe 2615'
2/13 _____
2/20 _____
2/27 _____
3/6 _____
3/13 set 6" - 2615' Ply out
3/20 - drly 2615'
4/10 fsg tools 2615'
4/17 _____
4/24 _____
5/1 S.D. 2615'
5/8 _____
5/14 verly 2700'
5/22 S.D. 2700'
5/29 S.D. 3030'
6/5 _____
6/12 verly 3088
6/19 3168 - St. Ream. 5"
6/26 verly 3200'
7/2 Wilcox 3226-34
T.D. 3250' - HFW
Abandoned

MAP NO. 100 SEC. 21 TWP. 16 R. 1W

WELL NO. 17 Threlkheld

O. C. Boyle & Co COMPANY

CONTRACTOR

SECTION PLAT

_____ FT. FROM N. LINE

330 FT. FROM S. LINE

_____ FT. FROM E. LINE

330 FT. FROM W. LINE

FIRST REPORTS

RECORD

LOCATION ✓

CASED _____ IN. _____ FT.

RIG UP _____

SAND _____

DRILLING AND REMARKS:

GAS _____

OIL _____

TOTAL DEPTH _____

PRODUCTION

1ST 24 HRS. NAT. _____

1ST 24 HRS. AFTER SHOT _____

GAS _____ CU. FT.

DRY HOLE _____

ABANDONED _____

DATE

SEP 19 1928

S. J. LEWIS

192

SCOUT

Map No. **KANSAS** Sec. *21* Twp. *16* R. *1W*

Well No. *42* / *Throckmold*

O. A. Boyle & Co. Company
Contractor

SECTION PLAT

..... Ft. from N. Line
330 Ft. from S. Line
..... Ft. from E. Line
330 Ft. from W. Line

ABANDONED

Location.....
Rig up.....
Drilling and Remarks:

Helcot 3 226-34
NFW

RECORD

Cased..... in., ft.
Sand.....
Gas.....
Oil.....
Total Depth *3250*

PRODUCTION

1st 24 hrs. Nat.....
1st 24 hrs. after shot.....
Gas..... Cu. Ft.
Dry Hole.....
Abandoned.....

Date

JUL 2 1929

192.....

S. J. LEWIS

Scout