

Section 1 Township 16 Range 11-WWell No. #1 PoppCompany B & R Drlg.

NORTH

O.W.W.O.

WEST

EAST

0							

SOUTH

12

Barton
16

KANSAS
14W

Sec. 1 Twp. 16 R. 14W

Well No. #1 Popp Farm

B & R Drlg. Company

B & R Drlg. Contractor

Trapp Pool **O.W.W.O.** NORTH

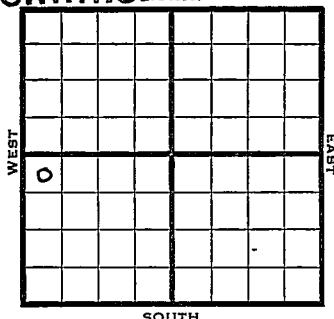
330' Ft. from N. Line

Ft. from S. Line

Ft. from E. Line

330' Ft. from W. Line

NW NW SW



1950 Elev 1856 REPORT

7/5 Spud 7-2-50
8" @ 170'
WOC

7/26 8" @ 170
Arb 3276-80
S/275' wtr 15 min
5½" @ 3276½
TD 3280
12/3276-78
250 acid
6/3278-79
SP 3190
17/3153-57
1 gfph SSO
250 acid
20 gwph
6/3094-98
250 acid
S/all wtr
D&A

ABANDONED

1950 **O.W.W.O.**
8/9 Comp. D&A Shows 2091-94, 3120-23, 3150
3150-60, 3271-80 DC to TD
S/5.56 BO 4 hr. Had 118 bbl total fluid
Ran Gammaray Sqz. off PB 3190'
17/3153-57 Test 1 go 250 A
S/20 BFPH SSO SP 3145 1/3093

OVER

1950

(Information brought forward)

16/3094-98 250 A S/13 B0 13/BW

11 hr 1000 A S/2.88 BFPH

Test 34.56 BFPD 18 ho 16.56 BW

Comp. 36 B0 33 BWPD

FIRST REPORT
COMPLETED

Kansas

Trapp Pool

Map No. _____ Sec. 1 Twp. 16 R. 14WWell No. 1 Popp

_____ B & R Drlg. _____ Company

_____ B & R Drlg. _____ Contractor

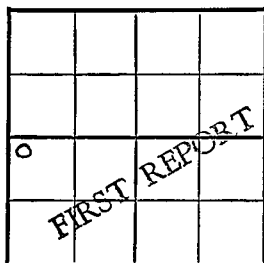
NW NW SW

SECTION PLAT

330 Ft. from N. Line

_____ Ft. from S. Line

_____ Ft. from E. Line

330 Ft. from W. Line

Barton County

Location _____

Rig up _____

Drilling and Remarks:

Spud 7-2-50

8" @ 170

WOC

RECORD

Cased _____ in., _____ ft.

Sand _____

Gas _____

Oil _____

Total Depth _____

PRODUCTION

1st 24 hrs. Nat. _____

1st 24 hrs. after shot _____

Gas _____ Cu. Ft.

Dry Hole _____

Abandoned _____

Date

Jul 5 1950J. E. TYRA Scout

Map No. _____ Sec. 1 Twp. 16 R. 14WWell No. 1 Popp

B & R Drlg.

Company

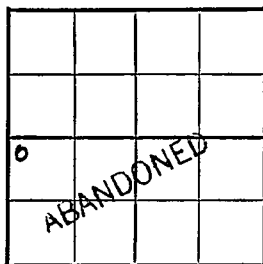
Contractor

NW NW SW

E1. 1856
SECTION PLAT330 Ft. from N. Line

_____ Ft. from S. Line

_____ Ft. from E. Line

330 Ft. from W. LineBarton County

Location _____

Rig up _____

Drilling and Remarks:

8" @ 170

Arb. 3276-80

S/ 275' water 15 min.

5 1/2" @ 3276 1/2

TD 3280

12/ 3276-78

250 acid

RECORD

Cased _____ in., _____ ft.

Sand _____

Gas _____

Oil _____

Total Depth 3280

PRODUCTION

1st 24 hrs. Nat. _____

1st 24 hrs. after shot _____

Gas _____ Cu. Ft.

Dry Hole _____

Abandoned _____

Date

JUL 26 1950 19J. E. TYRA Scout

6/ 3278-79

SP 3190

17/ 3153-57

1 gfph SSO

250 acid

20 bwph

6/ 3094-98

250 acid

S/all-water

D & A

Aug 1961

Misc.
Pledge Map
Franchise Map
Tracings
Land Wall Map
Land Small Map
Scout Cards

SECTION 17/1

O.W.W.O.

County Barton State Kansas

Sec. 1 (Blk. 16) (Sur. 147) Map No. _____
(Twp. 16) (Rge. 147)

Operator **B & R Driggs**

Well No. 7 Farm Poon

Elev.	Location	NW	NE	SW
-------	----------	----	----	----

0 FIRST REPORT COMPLETE

350 Ft. From N Line SW

330 Ft. From ~~the~~ Line Quarter

1st. Report AUG 9 1950

Completion

Remarks

1952

Spudding Date

Drig. Data

Comp. D & A Shows 3091-94 3120-23

3150-60 3271-80 DC to TD S/ 5.56 bo

4 hr. Had 118 bbl. total fluid

Rev Gammonray Sq. off PB 3190

17/ 3153-57 test 1 go 250 A

S/ 20 bfpb SS0 SP 3145 1/ 3093

16/ 3094-98 250 A S/ 13 bo 13 bw 11 h

7000 A S/ 2.88 bfph test 34.56 bfpd

18 no 16.56 bw

Comp. 36 to 33 bwpd

J. E. TYRA