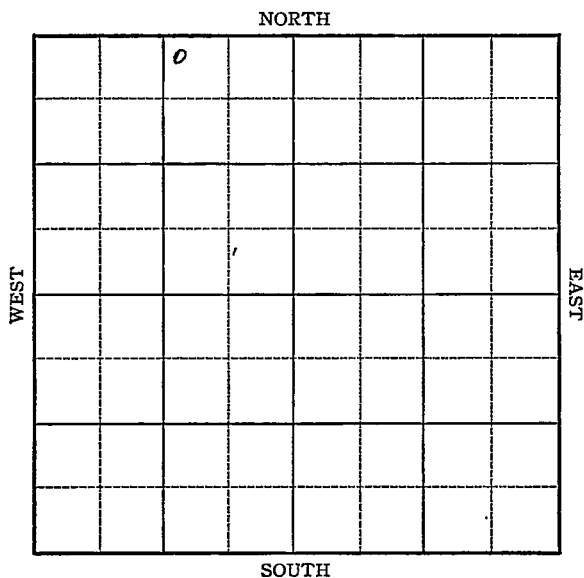


Section 1 Township 16 Range 14 ~~W~~Well No. 2 - Schneider "B"Company Shell

O. W. D. D

Sec. 1 Twp. 16 R. 14 WWell No. #2 Schneider "B" Farm

Shell

Company


330 Ft. from N. Line

Ft. from S. Line

979 Ft. from E. Line

Ft. from W. Line

Elev. 1857

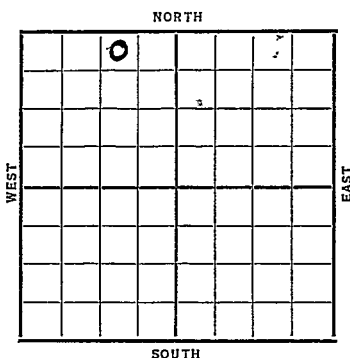

Date	REPORT	O. W. D. D
1937		
9/29	R U R	
10/8	Dr1 g. 650'.	
10/15	10" @ 650'. Dr1 g. 2330'.	
10/22	Dr1 g. 3275'.	
10/29	Sil. 3283'. 7" @ 3281'.	
	Coring 3289'. 1500' oil in 6 hrs.	
11/5	Recovered 4½' sat. core.	
	3289-94' T.D. 2200' oil 16 hrs. Swab 134 bbls. oil 3½ hrs.	
11/12	" " " " "	
11/19	" " " " "	
11/26	" " " " "	
12/3	T.D. 3294' SD.	
12/10	" " "	
12/17	" " "	
12/24	" " "	
12/31	" " "	
1938		
1/7	SD for pipe line.	

OVER



1938

1/14 T.D. 3294'.
SD for pipe line.

1/20 " " "

1/28 " " "

2/4 " " "

2/11 " " "

2/18 " " "

2/26 " " "

3/4 " " "

3/11 " " "

3/18 " " "

3/25 4000 acid.

3/30 7" @ 3281'.
Arb. 3283'.
T.D. 3294'.
4000 acid.
Potential 756 bbls.

COMPLETED

OVER

O. W. D. D

1939

2/1

Old T. D. 3294'.

Old potential 756 bbls.

T. D. 3310'.

2000 acid.

New potential 2248 bbls.

FIRST REPORT

and

COMPLETED

Barton **KANSAS**Map No. _____ Sec. 1 Twp. 16 R. 14WWell No. 2- Schneider "B"Shell Company_____
Contractor**FIRST REPORT**

NW NE NW

330 Ft. from N. Line

____ Ft. from S. Line

979 Ft. from E. Line

____ Ft. from W. Line

SECTION PLAT

	0		

Location _____

Rig up _____

Drilling and Remarks:

RUR**RECORD**

Cased _____ in., _____ ft.

Sand _____

Gas _____

Oil _____

Total Depth _____

PRODUCTION

1st 24-hrs. Nat. _____

1st 24 hrs. after shot _____

Gas _____ Cu. Ft.

Dry Hole _____

Abandoned _____

Date

SEP 29 1937 19 H. D. Hatfield Scout

Barton KANSAS

Map No. 23 Sec. 1 Twp. 16 R. 14WWell No. 2 Schneider "B"Shell

Company

Contractor

COMPLETED**SECTION PLAT**330 NW NE NW
Ft. from N. Line

Ft. from S. Line

979 Ft. from E. Line

Ft. from W. Line

	0		

Location

Rig up

Drilling and Remarks:

*4000 acid**pot 756***RECORD**Cased 7 in. 3281 ft.Sand Arb 3283

Gas

Oil

Total Depth 3294**PRODUCTION**

1st 24 hrs. Nat.

1st 24 hrs. after shot

Gas Cu. Ft.

Dry Hole

Abandoned

Date

MAR 30 1938

19

H. D. Hatfield Scout

Barton

KANSAS

Map No. _____ Sec. 1 Twp. 16 R. 14WWell No. 2 Schneider "B"

Shell

Company

Contractor

FIRST REPORT ~~& COMPLETED~~

SECTION PLAT

NW NE NW

330 Ft. from N. Line

_____ Ft. from S. Line

990 Ft. from E. Line

_____ Ft. from W. Line

	0		

TRAPP SOUTH POOL

Location _____

Rig up _____

Drilling and Remarks:

OWDD-OTD 3294

Old Poten. 756

T.D. 3310

2000 Acid

New Poten. 2248

RECORD

Cased _____ in., _____ ft.

Sand _____

Gas _____

Oil _____

Total Depth _____

PRODUCTION

1st 24 hrs. Nat. _____

1st 24 hrs. after shot _____

Gas _____ Cu. Ft.

Dry Hole _____

Abandoned _____

Date

FEB 1 - 1939 19

H. D. Hatfield Scout