

O.W.W.O.

Russell

KANSAS

Section 23 Township 14 Range 13W

Well No. #2<sup>1A</sup>Bond


Company Fred Haynes

NORTH

10

WEST

EAST

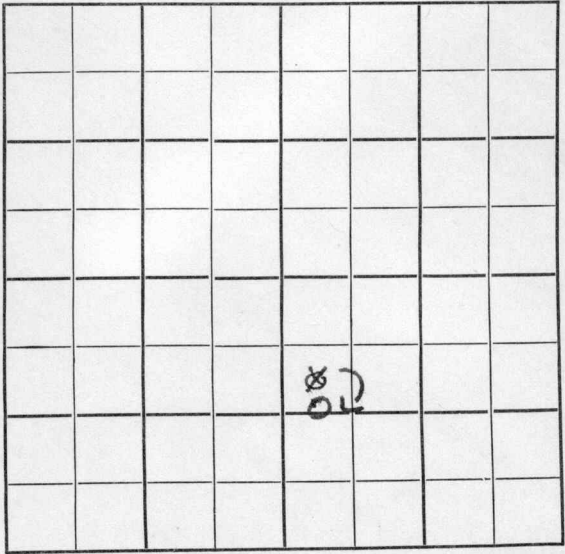

SOUTH

O.W.W.O.

Russell

KANSAS

Sec. 23 Twp. 14 R. 13 W

Well No. # 2<sup>nd</sup> Bond Farm

Fred Haynes Company

SHIELDS  
Haynes Contractor

HALL-GUANBY POOL


~~990~~ Ft. from N. Line

1320 Ft. from S. Line

\_\_\_\_\_ Ft. from E. Line

330 Ft. from W. Line

SW NW SE

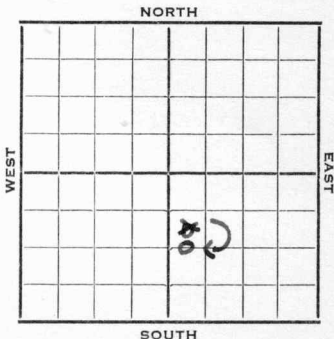

1952 Elev. 1753' REPORT

9/24	Spud 9-20-52 10" @ 371' Drlg. 490'
10/2	Anhy 686' 8" @ 686 Drlg. 1575'
10/8	Tarkio 2273 7" @ 2277 TD 2280 B/4 goph Sd-frac
10/15	"
10/22	Spud 9-20-52 Oil Well TD 2280' 10" @ 371' Anhy 686', 8" @ 686' Tarkio 2273' 7" @ 2277 TD 2280' B/4 goph sd-frac S/2 boph Comp. 25 bopd

**COMPLETED**

**OVER**

O.W.W.O.

1955  
3/30

Tarkio 2273'  
OTD 2280  
7" @ 2277'  
Drlg. 2990'

4/6

Oil Well; TD 3194, Tarkio 2273  
OTD 2280, 7" @ 2277, KC 2891,  
Arb 3192 TD 3194, 5" @ 3192  
CO to 3194, FU 1400' oil 16 hr.  
Comp. 25 BOPD

**COMPLETED**







County Russell State Kansas

Sec. 23 (Blk. Twp.) 14 (Sur. Rge.) 13W Map No.

Operator Fred Haynes

Well No. 2 Farm Jim Bond

Elev. 1753 Location C W $\frac{1}{2}$  W $\frac{1}{2}$  SE


1320 Ft. From S Line SE

330 Ft. From W Line Quarter

1st. Report

Completion APR 6 1955

Remarks Hall-Gurney Pool

Shields - Contr.

Spudding Date

Drlg. Data Oil well TD 3194

Tarkio 2273 OTD 2280 7" @ 2277

KC 2891 Arb. 3192 TD 3194 5" @ 3192

CO to 3194 FU 1400' oil 16 hr.

Comp. 25 bopd