


Section 28 Township 16 Range 1 W

Well No. # 1 Karber

Company F. S. Williams

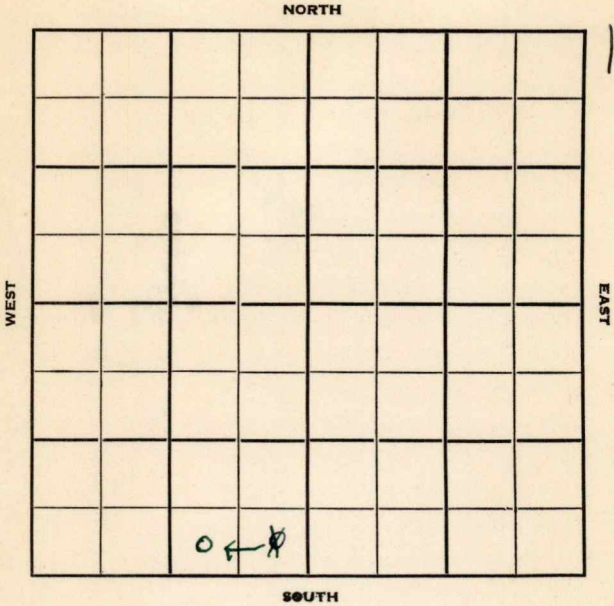

Sec. 28 Twp. 16 R. 1W

Well No. #1 Karber Farm

F.S. Williams Company

Contractor

Ft. from N. Line

330


Ft. from S. Line

~~990~~
330

Ft. from E. Line

Ft. from W. Line

~~SW SE SW~~
~~SE SE SW~~

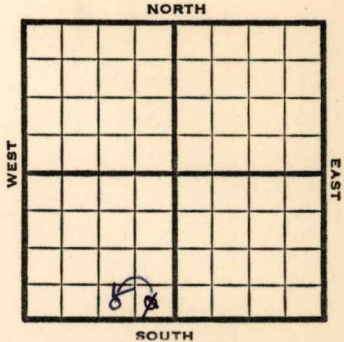

1951

Elev. 1276'

REPORT

10/31

Location

12/12

Spud 11-18-51

D&A TD 3332

8" @ 135 Br Lime 1932

Lans. 1988

DST 1995-2007 opn 1 hr Rec. 5' oil
10' ocm

Miss 2600 Kh 2846

Hunton 2947 Sylvan sh 3063

Maq. 3108 Viola 3143

Simp 3227 Arb. 3308

TD 3332

D&A

ABANDONED

Map No. _____ Sec. 28 Twp. 16 R. 1W

Well No. 1 Karber

F. S. Williams Company

CORRECTION Contractor

SW SE SW

SECTION PLAT

_____ Ft. from N. Line

330 Ft. from S. Line

990 Ft. from E. Line

_____ Ft. from W. Line

Saline County

Location _____

Rig up _____

Drilling and Remarks:

Reported

SE SE SW

RECORD

Cased _____ in., _____ ft.

Sand _____

Gas _____

Oil _____

Total Depth _____

PRODUCTION

1st 24 hrs. Nat. _____

1st 24 hrs. after shot _____

Gas _____ Cu. Ft.

Dry Hole _____

Abandoned _____

Date

NOV 21 1951

19

J. E. TYRA

Scout

