

Butler

FORM 51

KANSAS

Section 19 Township 29 Range 8E

Well No. 14 #1 Shinn

Company Weideman

NORTH

						0	

WEST

EAST

SOUTH

Butler

KANSAS ✓

Sec. 19 Twp. 29 R. 8E

Well No. #14 Shinn Farm

Weideman Company

Contractor


330 Ft. from N. Line

Ft. from S. Line

990 Ft. from E. Line

Ft. from W. Line

NW NE NE

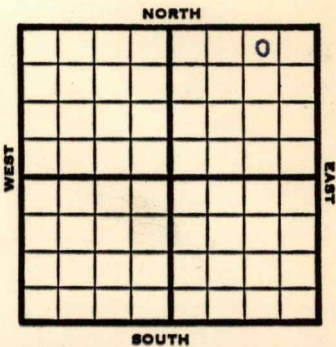

1953 Elev. - REPORT

8/12

Location

9/9

Spud 8-10-53

Oil Well

TD 2814'

10" @ 22'

KC 1999', B KC 2238', Marm 2342,
Cherokee 2490', Miss 2766

TD 2795'

7" @ 2795'

DD 2814

1500 A

Comp. 25 bopd.

COMPLETED

Kansas

Map No. _____ Sec. 19 Twp. 29 R. 8E

Well No. 14 Shinn

Weidemann Company

CORRECTION

Contractor

NW NE NE

SECTION PLAT

330 Ft. from N. Line

_____ Ft. from S. Line

990 Ft. from E. Line

_____ Ft. from W. Line

			0

Butler County

Location _____

Rig up _____

Drilling and Remarks:

Reported

#4 Shinn

RECORD

Cased _____ in., _____ ft.

Sand _____

Gas _____

Oil _____

Total Depth _____

PRODUCTION

1st 24 hrs. Nat. _____

1st 24 hrs. after shot _____

Gas _____ Cu. Ft.

Dry Hole _____

Abandoned _____

Date

AUG 10 1952

J. G. MCGEEHEE Scout

