

DX 78-1

Summer KANSAS

Section 36 Township 34 Range 2E

Well No. 6 Airport

Company Orville H. Parker

*3*

NORTH

			0				

WEST

EAST

SOUTH

Summer KANSAS.

SEC.	TWP.	R.
36	34	2E

WELL NO. 6 Airport FARM

COMPANY Orville H. Parker


CONTRACTOR Smitherman

Hilltop Pool  
330 Ft. from N. Line

Ft. from S. Line

330 Ft. from E. Line

Ft. from W. Line

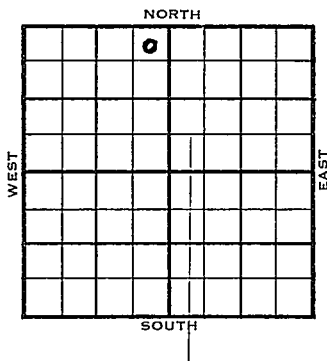

NE NE NW

1954	ELEVATION 1231'	REPORT
------	--------------------	--------

9/1  
10/6

Spud 8-30-54  
 Spud 8-30-54 Oil well TD 3533  
 8-5/8" @ 107 Bart. 3491 Layton 2813  
 KC 2998 Big line 3203 Bart 3509  
 Miss 2522 TD 3533 5" @ 3533  
 CO to TD 24/3528-34 F/25 BOPH  
 Comp. 25 BOPD

**COMPLETED**



