


Section 36 Township 34 Range 2E

Well No. 7 Airport

Company Orville Parker

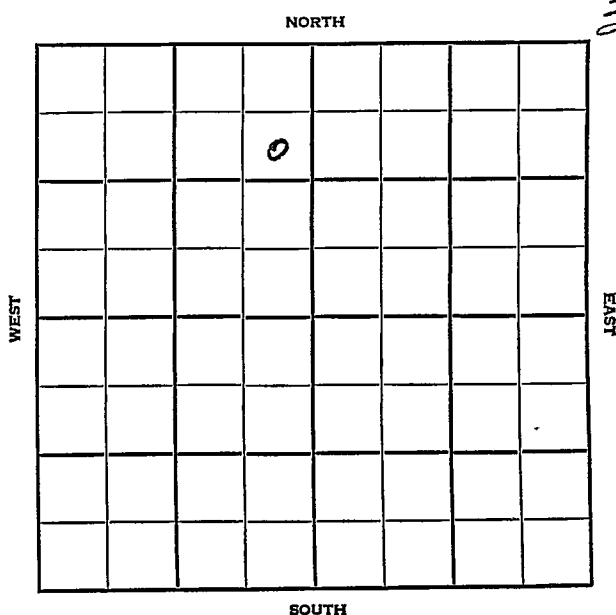

Sumner KANSAS

SEC.	TWP.	R.
36	34	2E

WELL NO. \_\_\_\_\_

COMPANY **7 Airport** FARM

**Orville Parker**

CONTRACTOR

**Smitherman Tools**


**Airport Pool**

990 \_\_\_\_\_ Ft. from N. Line

\_\_\_\_\_ Ft. from S. Line

330 \_\_\_\_\_ Ft. from E. Line

\_\_\_\_\_ Ft. from W. Line

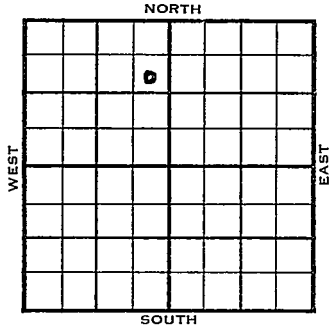

SE NE NW

1954	ELEVATION 1233'	REPORT
------	--------------------	--------

9/22 Spud 9-18-54  
8" @ 108'  
Drlg. 2200'

11/3 Spud 9-18-54 - Oil Well  
TD 3535'  
8" @ 108'  
Stal. 2365', Layton 2818'  
DST 2818-26', opn 1 hr., rec. 29'  
sgcm, 725#  
Bart. 3474', Miss 3534'  
TD 3535'  
5" @ 3535'  
F/80 bo 6-hrs.  
44/3520-31,  
Comp. 25 bopd

**COMPLETED**



