


KANSAS



Section 19 Township 29 Range 8E

Well No. #8 Skinn

Company K.T. Weidemann

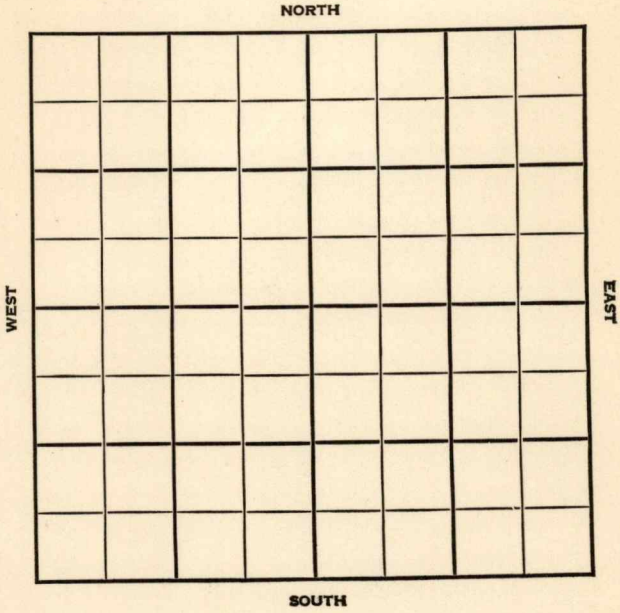

Sec. 19 Twp. 29 R. 8E

Well No. #8 Skinn Farm

K. T. Weidemann Company


Misc.

Lot 1  
Ft. from N. Line

990 Ft. from S. Line Lot 1

330 Ft. from E. Line Lot 1

Ft. from W. Line

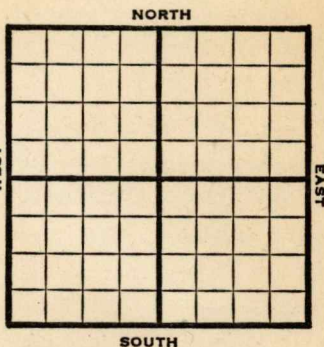

1947	Elev. - REPORT
11/19	20" @ 30' Drlg. 1330'
11/25	Mississippi 2740-70' 2770' TD 5" @ 2770' RUST
12/3	"
12/10	"
12/17	"
1948	
1/7	Miss. 2740' 5" @ 2770' Pump 100 Pot. Gr. 38° Total Depth 2793' <b>COMPLETED</b>

Map No. 10 Sec. 19 Twp. 29 R. 8E

Well No. 8 Skinn

K. T. Weidemann Company

COMPLETE

Contractor

Lot 1

SECTION PLAT

\_\_\_\_\_ Ft. from N. Line

990 Ft. from S. Line Lot 1

330 Ft. from E. Line Lot 1

\_\_\_\_\_ Ft. from W. Line


Butler County

Location \_\_\_\_\_

Rig up \_\_\_\_\_

Drilling and Remarks:

*Miss 2770*

*5" @ 2770*

*Pump 100 BT*

*08° SW*

RECORD

Cased \_\_\_\_\_ in., \_\_\_\_\_ ft.

Sand \_\_\_\_\_

Gas \_\_\_\_\_

Oil \_\_\_\_\_

Total Depth 2793

PRODUCTION

1st 24 hrs. Nat. \_\_\_\_\_

1st 24 hrs. after shot \_\_\_\_\_

Gas \_\_\_\_\_ Cu. Ft.

Dry Hole \_\_\_\_\_

Abandoned \_\_\_\_\_

Date

JAN 7 1948 19

S. J. LEWIS Scout

Map No. \_\_\_\_\_ Sec. 19 Twp. 29 R. 8E

Well No. 8 Skinn

K. T. Weidemann Company

FIRST REPORT

Contractor

Lot 1

SECTION PLAT

\_\_\_\_\_ Ft. from N. Line

990 Ft. from S. Line *lot 1*

330 Ft. from E. Line *lot 1*

\_\_\_\_\_ Ft. from W. Line


Butler County

Location \_\_\_\_\_

Rig up \_\_\_\_\_

Drilling and Remarks:

20" @ 30

drlg. 1330

RECORD

Cased \_\_\_\_\_ in., \_\_\_\_\_ ft.

Sand \_\_\_\_\_

Gas \_\_\_\_\_

Oil \_\_\_\_\_

Total Depth \_\_\_\_\_

PRODUCTION

1st 24 hrs. Nat. \_\_\_\_\_

1st 24 hrs. after shot \_\_\_\_\_

Gas \_\_\_\_\_ Cu. Ft.

Dry Hole \_\_\_\_\_

Abandoned \_\_\_\_\_

Date

NOV 1 9 1947 19

S. J. LEWIS Scout