

DX 78-1

Summer KANSAS

36

34

2 E

Section _____ Township _____ Range _____

Well No. # 8 Airport

Company O. Parker

NORTH

6

WEST

EAST

	X						
			0				

SOUTH

Summer KANSAS

SEC. 36	TWP. 34	R. 2E
------------	------------	----------

WELL NO. 8 Airport FARM

COMPANY O. Parker


CONTRACTOR Smitherman Tools #1 Rig
Hilltop Pool

~~990~~ Ft. from N. Line

990 Ft. from S. Line

330 Ft. from E. Line

990 Ft. from W. Line

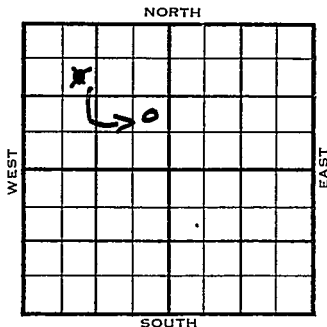

NE SE
~~SE NW NW~~

	ELEVATION	REPORT
1954	1234'	

9/29 Spud 9-25-54
8" @ 114'
Drlg. 885'

10/27 Spud 9-25-54 Oil well TD 3564
8" @ 114' Severy sd 1606 Layton 2812
KC 2998 Big lime 3199 Bart 3480
Miss 3540 DST 3540-63, open 1 1/2 hr
rec 640' gas, 210' fluid 120' HO &
GCM, 90' oily muddy SW 1045#
TD 3564 5" @ 3564 CO to 3564
69/3516-39 F/30 BOPH
Comp. 25 BOPD

COMPLETED

KADDEES

Map No. _____ Sec. 36 Twp. 34 R. 2E

Well No. 8 Airport

O. Parker Company

Contractor

NE SE NW

SECTION PLAT

_____ Ft. from N. Line

990 Ft. from S. Line

330 Ft. from E. Line

_____ Ft. from W. Line


	o		

Sumner County

Location _____

Rig up _____

Drilling and Remarks:

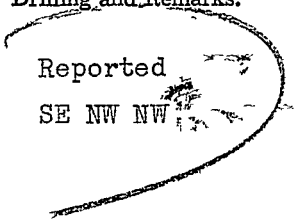

RECORD

Cased _____ in., _____ ft.

Sand _____

Gas _____

Oil _____

Total Depth _____

PRODUCTION

1st 24 hrs. Nat. _____

1st 24 hrs. after shot _____

Gas _____ Cu. Ft.

Dry Hole _____

Abandoned _____

Date

OCT 20 1954

FABEN GILSTRAP

Scout

