


KANSAS

Butler

Section 19 Township 29 Range 3E

Well No. #9 Shinn

Company K.T. Weidemann

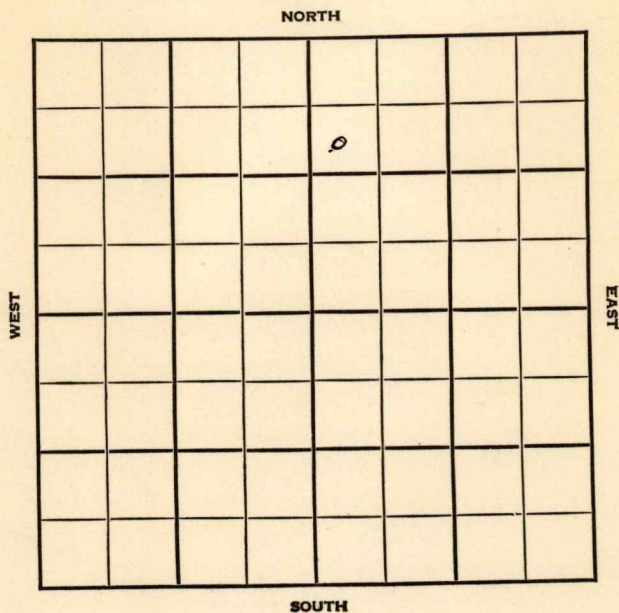

KANSAS

Butler

Sec. 19 Twp. 29 R. 8-E

Well No. #9 Shinn Farm

K. T. Weidemann Company

Miscellaneous


990' Ft. from N. Line

Ft. from S. Line

Ft. from E. Line

330' Ft. from W. Line

SW NW NE

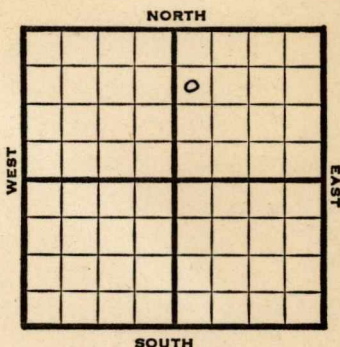

1947

REPORT

11/25 RUR

12/3 20" @ 401'
Drlg. 2360'

12/10 Mississippi 2741-72
TD 5" @ 2722

12/17 "

12/30 "

1948
1/78 "

1/14 "

1/21 "

1/26 "

2/4 "

2/111 Miss. 2741'
5" @ 2722'
Pump 15 Pot
38.0 Gr.
TD 2796'
Comp.

COMPLETED

Map No. _____ Sec. 19 Twp. 29 R. 8E

Well No. 9 Shinn

K. T. Weidemann Company

FIRST REPORT

Contractor

SW NW NE


SECTION PLAT

990 Ft. from N. Line

_____ Ft. from S. Line

_____ Ft. from E. Line

330 Ft. from W. Line

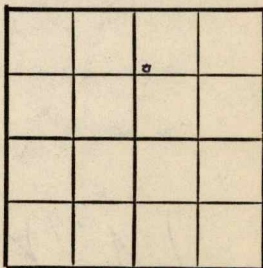

Butler County

Location _____

Rig up _____

Drilling and Remarks:

R U R

RECORD

Cased _____ in., _____ ft.

Sand _____

Gas _____

Oil _____

Total Depth _____

PRODUCTION

1st 24 hrs. Nat. _____

1st 24 hrs. after shot _____

Gas _____ Cu. Ft.

Dry Hole _____

Abandoned _____

Date

NOV 25 1947 19

S. J. LEWIS Scout

Map No. 10 Sec. 19 Twp. 29 R. 8E

Well No. 98 ^{5B} Shinn

K. T. Weidemann Company

COMPLETE Contractor

SW NW NE


SECTION PLAT

990 Ft. from N. Line

 Ft. from S. Line

 Ft. from E. Line

330 Ft. from W. Line

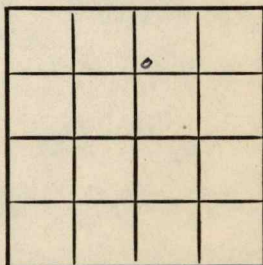

Butler County

Location

Rig up

Drilling and Remarks:

Miss 2741

5' @ 2722

Pump 15 Rod

28 3/4

RECORD

Cased in., ft.

Sand

Gas

Oil ✓

Total Depth 2296

PRODUCTION

1st 24 hrs. Nat.

1st 24 hrs. after shot

Gas Cu. Ft.

Dry Hole

Abandoned

Date

FEB 11 1948

19

3. J. LEWIS

Scout