

# O.W.D.D

Butler

KANSAS

SECTION 19 TOWNSHIP 29 RANGE 8 E

WELL NO. #12 Shinn

COMPANY Beaumont Pet.

NORTH

				0			

WEST

EAST


SOUTH

SEC. 19 TWP. 29 R. 8 E  
 WELL NO. # 12 Shinn FARM  
 COMPANY

CONTRACTOR  
 Beaumont Pet.

Co. tools  
 Shinn

\_\_\_\_\_ Ft. from N. Line  
 \_\_\_\_\_ Ft. from S. Line  
 \_\_\_\_\_ Ft. from E. Line  
 \_\_\_\_\_ Ft. from W. Line

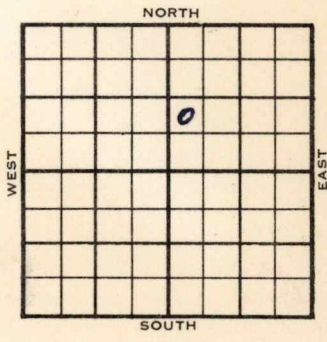

NW SW NE

1956 ELEVATION REPORT

O. W. D. D. NO-RECORD

1/11 OTD 2200' 7" @ 2155 DD 2850'  
 4 1/2" @ 2850 WOCT  
 KC 1995', BKC 2334', M. 2752'  
 TD 2200'

1-25 24/ 2816-22, 16/ 2806-10,  
 3 goph  
 FU 370' oil 12 hrs., 1000 A  
 Comp. 25 bopd  
 KC 1995  
 BKC 2334  
 M. 2752  
 TD 2850

COMPLETED

# O. W. D. D

FORM 513 REV. SUNRAY

**OWDD**

County **Butler** Elev. \_\_\_\_\_  
 Sec. **19** Twp. **29** Rge. **8E**  
 Company **Beaumont Pet.**  
 Farm Name **Shinn** No. **12**

TOPS	DEPTH	LOG	DATUM	Loc. in Sec.
Anh.				NW SW NE
Tp.				
H.				
Tr.				
Dg.				
Bl.				
L.				Geol. _____
K.C.	1995			Contr. _____
B.K.C.	2334			
Ce.				Co. tools _____
C.				
M.				Pool _____
M.	2752			
K.				Shinn
Mz.				
Me.				
V.				
S.				
S.				
A.				
R.				
Pe.				
G.				
T.D.	2200			

**NO RECORD**

JAN 1 '56  
 0  
**FIRST REPORT**

Date Comm.

OTD 2200 7" @ 2155 DD 2850

4 1/2" @ 2850 WOCT

OWDD

County Butler Elev. \_\_\_\_\_  
 Sec. 19 Twp. 29 Rge. 8E  
 Company Beaumont Pet.  
 Farm Name Shinn No. 12

TOPS	DEPTH	LOG	DATUM
Anh.			
Tr.			
H.			
Tr.			
Dg.			
Bl.			
L.			
K.C.	<u>1995</u>		
B.K.C.	<u>2334</u>		
Ce.			
C.			
M.	<u>2752</u>		
M.			
K.			
Mz.			
Me.			
V.			
S.			
S.			
A			
R.			
Pe.			
G.			
	<u>2850</u>		
T.D.	<u>2200</u>		

Loc. in Sec. NW SW NE  
 Geol. \_\_\_\_\_  
 Contr. Co. tools  
 Pool Shinn

	0		

COMPLETE

Date Comm. JAN 25 1956

OTD 2200 7" @ 2155 DD 2850  
 4 1/2" @ 2850 24/ 2816-22 16/ 2806-10  
 3 goph FU 370' oil 12 hr. 1000 A  
 Comp. 25 bopd

Co.  
Lse.  
No.  
Sec.  
T.  
R.