

Butler


KANSAS

SECTION 19 TOWNSHIP 29 RANGE 8 E

WELL NO. #18 Shinn

COMPANY Beaumont Petroleum Co.

NORTH

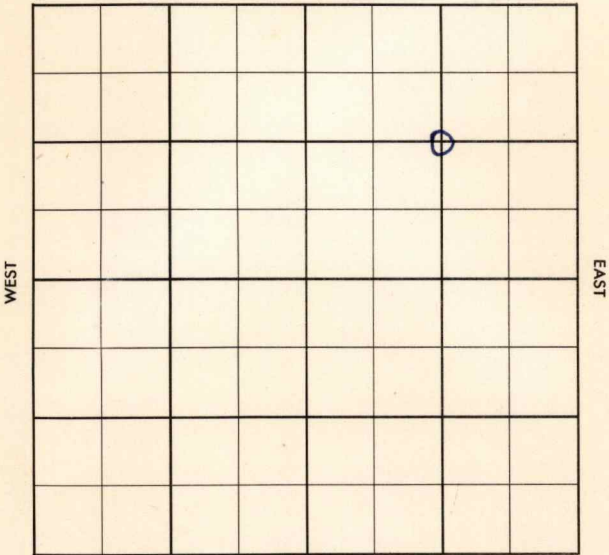

SOUTH

Butler

KANSAS

SEC. 19	TWP. 29	R. 8E
------------	------------	----------

WELL NO. #18 Shinn FARM

COMPANY
Beaumont Petr. Co.

CONTRACTOR
Co. tools

Shinn


_____ Ft. from N. Line

_____ Ft. from S. Line

_____ Ft. from E. Line

_____ Ft. from W. Line

C NE/4

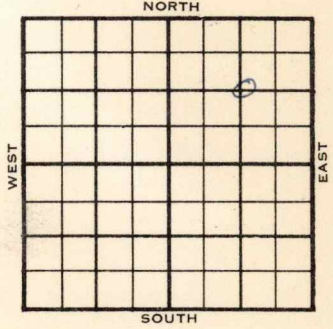

1956	ELEVATION	REPORT
------	-----------	--------

1-5	10" @ 35 DST 2225 KC 1997'	
2-8	P/25 BOPD, no/wtr. KC 1997 M.Li. 2751 TD 2781	

COMPLETED

County **Butler** Elev. _____
 Sec. **19** Twp. **29** Rge. **8E**
 Company **Beaumont Petroleum Co.**
 Farm Name **Shinn** No. **18**

TOPS	DEPTH	LOG	DATUM	Loc. in Sec.												
Anh.				C NE/4												
Tr.																
H.																
Tr.																
Dg.																
Bl.																
L.				Geol. _____												
K.C.	1997			Contr. _____												
B.K.C.				Co. tools												
Ce.																
C.				Pool _____												
M.																
M.				Shinn												
K.																
Mz.				<table border="1"> <tr> <td></td> <td></td> <td></td> </tr> <tr> <td></td> <td></td> <td style="text-align: center;">●</td> </tr> <tr> <td colspan="3" style="text-align: center;">FIRST REPORT</td> </tr> <tr> <td colspan="3" style="text-align: center;">JAN 5 '58</td> </tr> </table>						●	FIRST REPORT			JAN 5 '58		
		●														
FIRST REPORT																
JAN 5 '58																
Mq.																
V.																
S.																
S.																
A.																
R.																
Pe.																
G.																
T.D.																

Date Comm. **10" @ 35 DST 2225**

Co.
Lse.
No.
Sec.
T.
R.

