

Section 36 Township 34 Range 2 E

Well No. # 11 Airport

Company Orville Parker

NORTH

5

WEST

	0						

EAST

SOUTH

Sumner KANSAS

SEC.	TWP.	R.
36	34	2E

WELL NO
11 Airport FARM

COMPANY
Orville Parker

CONTRACTOR
Smitherman


Hilltop Pool

_____ Ft. from N. Line

330 _____ Ft. from S. Line

_____ Ft. from E. Line

990 _____ Ft. from W. Line

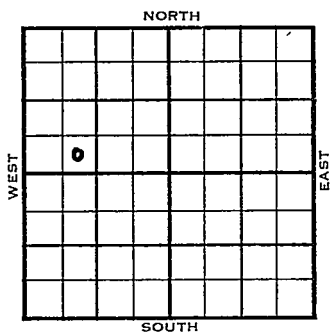

SE SW NW

1954	ELEVATION	REPORT
	1228'	

10/13
11/23

Location
Spud
Oil Well
TD 3547'
8-5/8" @ 120'
Severy Sd. 1592' Layton 2806'
KC 3012', Big Lime Oswego 3218',
Bart. 3525'
TD 3547'
5" @ 3547'
2 1/4 / 3525-31 frac.
P/ 40 boph
Comp 25 bopd.

COMPLETED

