

DX 78-1


Summer

KANSAS

Section 36 Township 34 Range 2 E

Well No. # 12 Airport

Company Orville Parker

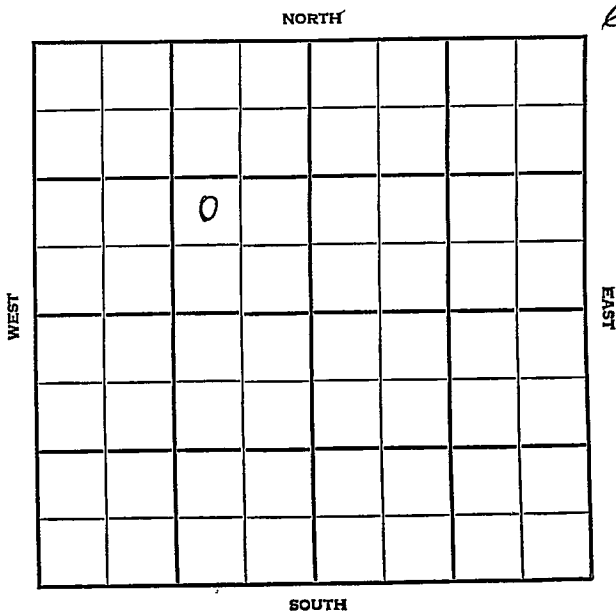

Summer KANSAS

SEC.	TWP.	R.
36	34	2E

WELL NO. 12 Airport FARM

COMPANY

CONTRACTOR Orville Parker

Smitherman

Hilltop Pool


_____ Ft. from N. Line

990 _____ Ft. from S. Line

990 _____ Ft. from E. Line

_____ Ft. from W. Line

NW SE NW

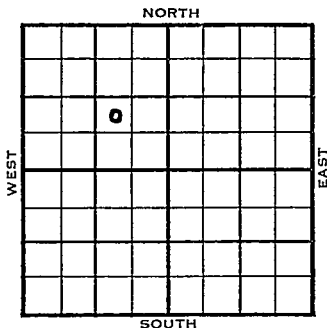

1954

ELEVATION

1233'

REPORT

10/13 Location

12/8 Spud 11-8-54 Oil well TD 3556
 Layton 2806 KC 3006 Oswego 3207
 Bart 3475 Bart. sd. 3498 Miss 3547
 TD 3556 5" @ 3556 GO to 3551
 72/3523-41 F/28 BOPH
 Comp. 25 BOPD

COMPLETED

County Sumner State Kansas

Sec. 36 (Blk. Twp.) 34 (Sur. Rge.) 2E Map No.

Operator Orville Parker

Well No. 12 Farm Airport

Elev. _____ Location NW SE NW

	0				
FIRST REPORT					

990 Ft. From S Line NW

990 Ft. From E Line Quarter

1st. Report OCT 13 1954

Completion _____

Remarks _____

Smitherman - Contr.

Spudding Date _____

Drlg. Data Hilltop Pool

Location

FABEN GILSTRAP

