


DX 78-1 Butler

KANSAS

Section 19 Township 29S Range 8E

Well No. #20 Shinn

Company Beaumont Pet

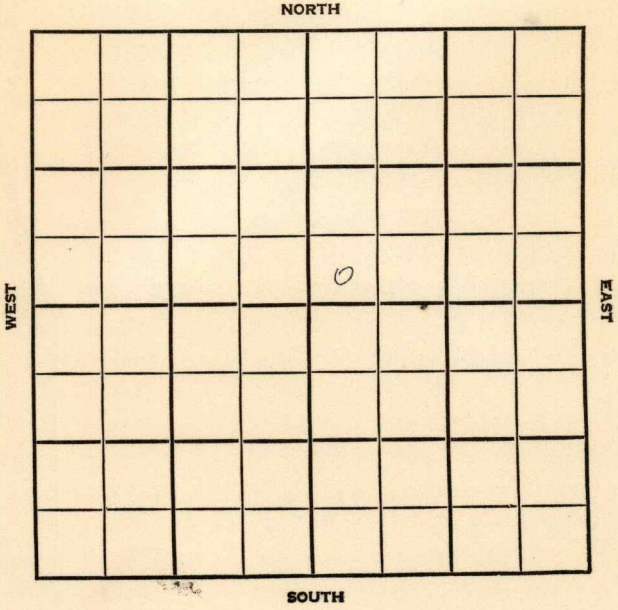

Butler


SEC. 19	TWP. 29	R. 8E
------------	------------	----------

WELL NO. #20 Shinn (SWD) FARM

COMPANY
Beaumont Petr.

CONTRACTOR
Shinn

_____ FT. FROM N. LINE
 _____ FT. FROM S. LINE
 _____ FT. FROM E. LINE
 _____ FT. FROM W. LINE
 SW SW NE (Twin to #1)

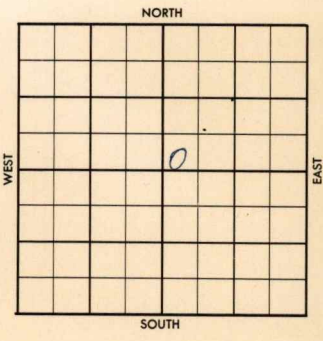

1956	ELEVATION 5145 KB	REPORT
------	----------------------	--------

8-1 MIRT
For SWD

8-15 Comm. 7-30-56
 10" @ 40'
 7" @ 3133 w/125
 CO 3220
 Comp. SWD Well.
 KC. 1984'; BKG 2215'; M. 2722';
 K. 2958'; A. 3126';
 TD 3220'

ABANDONED

County Butler Elev. _____
 Sec. 19 Twp. 29S Rge. 8E
 Company Beaumont Pet.
 Farm Name Shinn No. 20

TOPS	DEPTH	LOG	DATUM
Anh.			
Tp.			
H.			
Tr.			
Dg.			
Bl.			
L.			
K.C.			
B.K.C.			
Ce.			
C.			
M.			
M.			
K.			
Mz.			
Ma.			
V.			
S.			
S.			
A.			
R.			
Pe.			
G.			
T.D.			

SWD
 Loc. in Sec. _____
 SW SW NE
 twin to #1

Geol. _____
 Contr. _____
 Pool _____
 Shinn

FIRST REPORT		
	0	

Date Comm. AUG 1 1956
MIRT for SWD

310

AUG 5 1956
 R.C.

Co.
 Lsc.
 No.
 Sec.
 T.
 R.

County Butler Elev. 1545 KTB
 Sec. 19 Twp. 29S Rgs. SE
 Company Beaumont Pet.
 Farm Name Shinn No. 20

TOPS	DEPTH	LOG	DATUM	SWD Loc. in Sec.
Anh.				SW SW NE
Tp.				twin to #1
H.				
Tr.				
Dg.				
Bl.				
L.				Geol.
K.C.	<u>1984</u>			Contr.
B.K.C.	<u>2215</u>			
Ce.				
C.				
M.	<u>2722</u>			Pool
M.				Shinn
K.	<u>2958</u>			<div style="border: 1px dashed black; padding: 5px; display: inline-block;"> ABANDONE </div>
Mz.				
Mo.				
V.				
S.				
S.				
A.	<u>3126</u>			
R.				
Pe.				
G.				
T.D.	<u>3220</u>			

Date Comm. AUG 15 '56
MIRT for SWD AUG 8 '56 7-30-56
10" 40' ID 2873
AUG 15 '56 7" @ 3133 / 125 CO 3220
comp SWD well.