


Section 36 Township 34 Range 2 E
Well No. # 12 Airport
Company McNeish & Gralapp

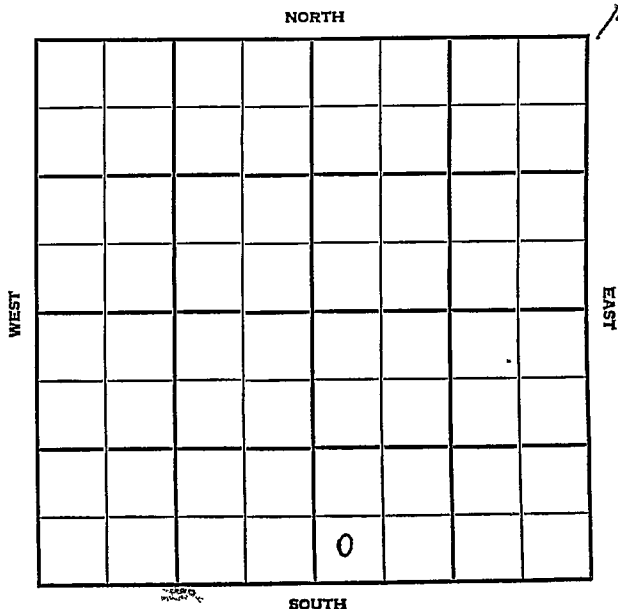

SEC.	TWP.	R.
36	34	2 E

WELL NO.

12 Airport

FARM

COMPANY

McNeish & Gralapp

CONTRACTOR

Watson

~~Hilltop Pool~~

Ft. from N. Line

330


Ft. from S. Line

Ft. from E. Line

330

Ft. from W. Line

SW SW SE

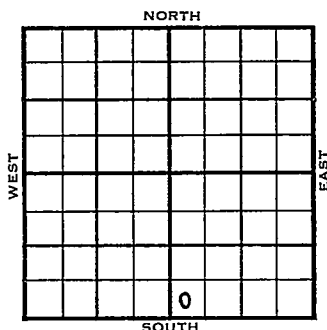

1954

ELEVATION
1213'

REPORT

12/29

Location

1955
2/9

Spud 1-7-55 Oil well TD 3532
 8" @ 100 Layton 2819 KC 3003
 Oswego 3208 Bart. 3483 TD 3532
 5" @ 3531 Perf/3504-14 frac.
 F/57 BOPH 3 hr.
 Comp. 25 BOPD

COMPLETED

TADEN GILSTRAP

FABEN GILSTRAP


County Sumner State **Kansas**

Sec. 36 (Blk.) 34 (Sur.) 2E Map No.

Operator McNeish & Gralapp

Well No. 12 Farm Airport

Elev. 1213 Location SW SW SE

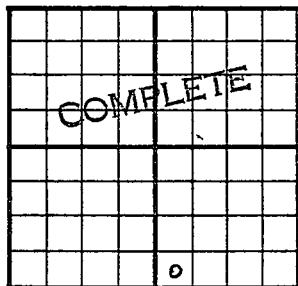

330 Ft. From S Line SE

330 Ft. From W Line Quarter

1st. Report

Completion FEB 9 1955

Remarks Hilltop Pool

Watson - Contr.

Spudding Date 1-7-55

Drlg. Data Oil well TD 3532

8" @ 100 Layton 2819 KC 3003

Oswego 3208 Bart. 3483 TD 3532

5" @ 3531 perf/ 3504-14 frac

F/ 57 boph 3 hr. Comp. 25 bopd

FABEN GILSTRAP