

Butler


KANSAS

SECTION 19 TOWNSHIP 29 RANGE 8E

WELL NO. #21 Shinn

COMPANY Beaumont Petr.

Approx. NENE SW
NORTH NE Cor. of Lot 18

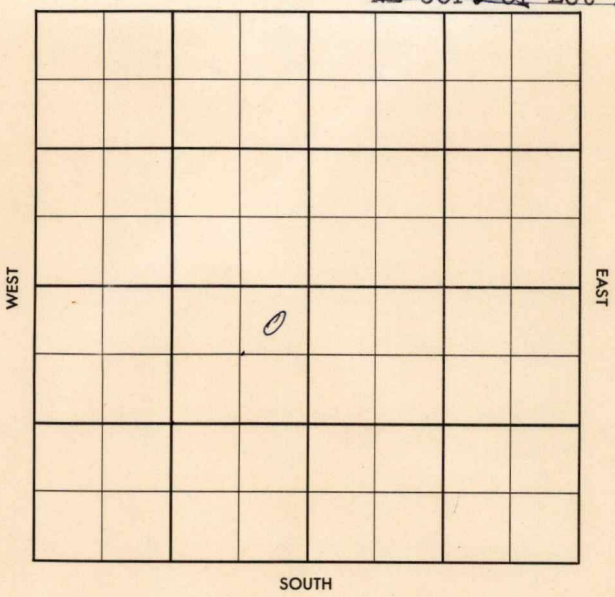

CORRECTION

FORM 513 SUNRAY

County Butler Elev. 1550 grd.
 Sec. 19 Twp. 29 Rge. 8E
 Company Beaumont. Pet.
 Farm Name Shinn No. 21

TOPS	DEPTH	LOG	DATUM	Loc. in Sec.						
				<u>APP. NENE SW</u>						
Anh.				<u>NE COR of</u>						
Tr.				<u>Lot 18</u>						
Dg.				<u>2900 FNL</u>						
Bl.				<u>3000' FEL</u>						
L.				Geol. _____						
K.C.	<u>1944</u>			Contr. _____						
B.K.C.	<u>2235</u>			Co. Tools _____						
Ge. <u>Marm</u>	<u>2330</u>			Pool _____						
C.e.	<u>2475</u>			<u>Shinn</u>						
M. <u>L1</u>	<u>2754</u>			<table border="1"> <tr><td colspan="2">COMPLETE</td></tr> <tr><td>o</td><td></td></tr> <tr><td>APR 3</td><td>57</td></tr> </table>	COMPLETE		o		APR 3	57
COMPLETE										
o										
APR 3	57									
M.										
K.										
Mz.										
Mq.										
V.										
S.										
A.										
R.										
PE.										
G.										
T.D.	<u>2851</u>									

Date Comm. 3-7-57
 10" @ 30/30, Drlg. 2050 W/R 20 3P
 7" @ 2851 MAR 27 '57 CO 5/2825-27
 \$ wth Bldg Plg 2818 25/2800
 -04 \$ s.o. APR 3 '57 F4 350 Fluid
 in 12 hrs 25% wth No. Pot
 P. 10 Bopd + 35 BwPd.

County Butler Elev. _____
 Sec. 19 Twp. 29 Rgs. 8E
 Company Beaumont Pet.
 Farm Name Shinn No. 21

TOPS	DEPTH	LOG	DATUM	Loc. in Sec. _____																																
Anh.				NE Cor of Lot 18																																
TP.																																				
H.																																				
Tr.																																				
Dg.				Geol. _____																																
Bl.																																				
L.				Contr. _____																																
K.C.																																				
B.K.C.				Co. Tools																																
Ce.																																				
C.				Pool																																
M.																																				
K.				Shinn																																
Mz.																																				
Me.				<table border="1"> <tr><td></td><td></td><td></td><td></td></tr> <tr><td></td><td></td><td></td><td></td></tr> <tr><td></td><td></td><td></td><td></td></tr> <tr><td></td><td></td><td></td><td></td></tr> <tr><td></td><td></td><td></td><td></td></tr> <tr><td></td><td></td><td></td><td></td></tr> <tr><td></td><td></td><td></td><td></td></tr> <tr><td></td><td></td><td></td><td></td></tr> </table>																																
V.																																				
S.																																				
S.																																				
A.																																				
R.																																				
Pe.																																				
G.																																				
T.D.																																				

FIRST REPORT
 MAR 13 '57

Date Comm. 3-7-57
10" @ 30/30, Drlg. 2050

~~30~~

Co.
Lse.
No.
Sec.
T.
R.