

Butler

KANSAS

19

29

8E

SECTION _____ TOWNSHIP _____ RANGE _____

#22 Shinn

WELL NO. _____

Beaumont Petroleum


COMPANY _____

NORTH

SE Cor. of Lot 1

WEST

EAST

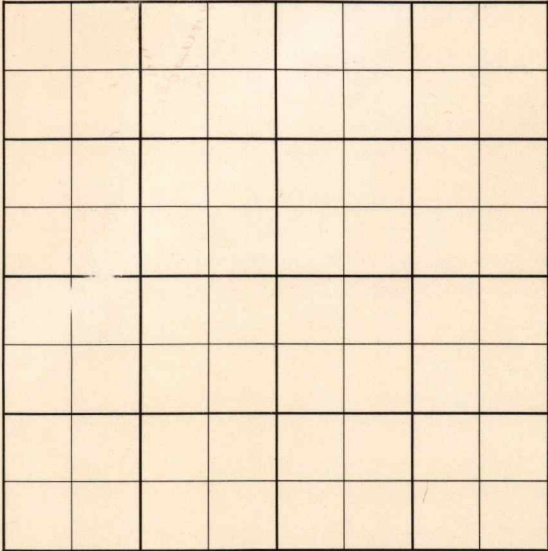

SOUTH

County Butler Elev. _____
 Sec. 19 Twp. 29 Rge. 8E
 Company Beaumont Petroleum
 Farm Name Shinn No. 22

TOPS	DEPTH	LOG	DATUM	Loc. in Sec.
Anh.				SE Cor of
TP.				
H.				Lot 1
Tr.				
Dg.				
Bl.				
L.				Geol. _____
K.C.				Contr. _____
B.K.C.				
Ce.				Co. Tools _____
C.				
M.				Pool _____
K.				Shinn
Mz.				
Mq.				
V.				
S.				
S.				FIRST REPORT
A.				
R.				
PE.				
G.				
T.D.				

WAR 20 '57

Date Comm. 3-15-57
8" @ Drlg. 1600

~~30~~

Co.
Lse.
No.
Sec.
T.
R.