

11-10-226

STATE CORPORATION COMMISSION OF KANSAS
OIL & GAS CONSERVATION DIVISION
WELL COMPLETION OR RECOMPLETION FORM
ACO-1 WELL HISTORY
DESCRIPTION OF WELL AND LEASE

Operator: License # 3070
Name Mil. Gulf, Inc.
Address P.O. Box 1648
City/State/Zip Brenham, TX 27833

Purchaser FAIRMONT PIPELINE SYSTEM, INC.

Operator Contact Person Derrall Krebs
Phone (409) 836-4574

Contractor: License # 4423
Name Van Drilling, Inc.

Wellsite Geologist Dix R. Turnbow
Phone (409) 836-4574

Designate Type of Completion

New Well Re-Entry Workover
 Oil SWD Temp Abd
 Gas Inj Delayed Comp.
 Dry Other (Core, Water Supply etc.)

If **OWWO**: old well info as follows:
Operator
Well Name
Comp. Date Old Total Depth.....

WELL HISTORY

Drilling Method:
 Mud Rotary Air Rotary Cable
4-23-87 4-24-87 4-29-87
Spud Date Date Reached TD Completion Date
1204' N/A
Total Depth PBTD

Amount of Surface Pipe Set and Cemented at 64.5 feet
Multiple Stage Cementing Collar Used? Yes No
If yes, show depth set.....feet
If alternate 2 completion, cement circulated
from 64.5 feet depth to 0' w/ 18 SX cmt
Cement Company Name Provided By Drilling Contractor
Invoice # N/A

API NO. 15-103-20,830
County Leavenworth
NW NE NE Sec. 11 Twp 1A S Rge. 22 East West



4950 Ft North from Southeast Corner of Section
990 Ft West from Southeast Corner of Section
(Note: Locate well in section plat below)


Lease Name Kraft Well # 1

Field Name Fairmount Townsite

Producing Formation McLouth

Elevation: Ground 960 KB 962

Section Plat

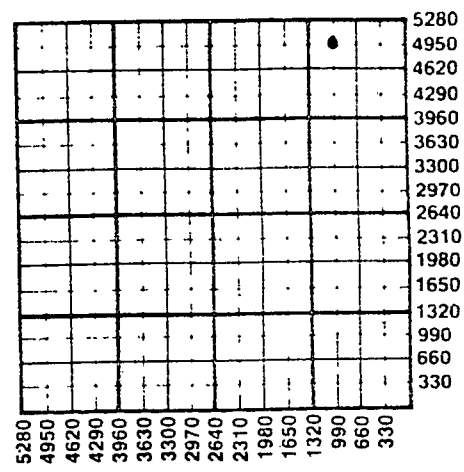

WATER SUPPLY INFORMATION

Disposition of Produced Water: Disposal
Docket # Repressuring

Questions on this portion of the ACO-1 call:
Water Resources Board (913) 296-3717

Source of Water:
Division of Water Resources Permit #.....
 Groundwater.....Ft North from Southeast Corner
(Well)Ft West from Southeast Corner of
Sec Twp Rge East West
 Surface Water.....Ft North from Southeast Corner
(Stream,pond etc).....Ft West from Southeast Corner
Sec Twp Rge East West
 Other (explain) Purchased
(purchased from city, R.W.D. #)

INSTRUCTIONS: This form shall be completed in triplicate and filed with the Kansas Corporation Commission, 200 Colorado Derby Building, Wichita, Kansas 67202, within 120 days of the spud date of any well. Rule 82-3-130, 82-3-107 and 82-3-106 apply. Information on side two of this form will be held confidential for a period of 12 months if requested in writing and submitted with the form. See rule 82-3-107 for confidentiality in excess of 12 months. One copy of all wireline logs and drillers time log shall be attached with this form. Submit CP-4 form with all plugged wells. Submit CP-111 form with all temporarily abandoned wells.