


Section 21 Township 14 Range 13W

Well No. #6 Graham

Company Shumaker

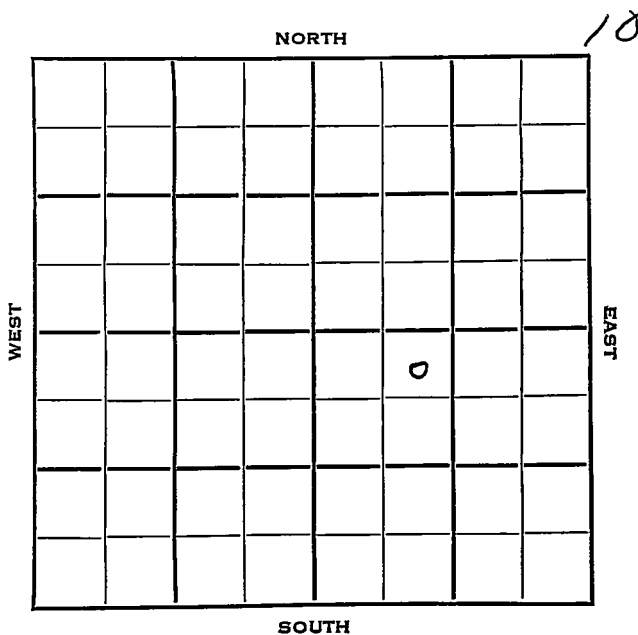

Sec. 21 Twp. 14 R. 13W

Well No. #6 Graham Farm

Shumaker Company

Jayhawk Contractor


330 Ft. from N. Line

_____ Ft. from S. Line

_____ Ft. from E. Line

990 Ft. from W. Line

NE NW SE

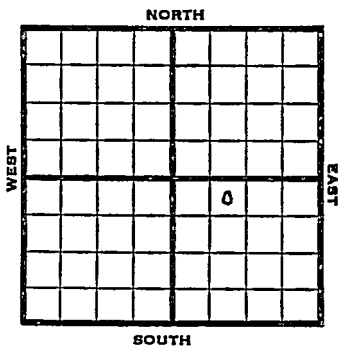

1953 Elev. 1784' REPORT

8/19 R U R

8/26 10" @ 425'
Drlg 575'

9/2 anhy 720'
8" @ 725'
Drlg 1600'

9/9 Spud 8-21-53
D&A
TD 2380
10" @ 425
Anhy 720
8" @ 725
Tarkio 2282
TD 2380
D&A

ABANDONED

County Russell State Kansas

Sec. 21 (Blk. Twp.) 14 (Sur. Rge.) 13W Map No.

Operator Stumaker

Well No. 6 Farm Graham

Elev. _____ Location NE NW SE

330 Ft. From N Line SE

990 Ft. From W Line Quarter

1st. Report AUG 19 1953

Completion _____

Remarks _____

Jayhawk - Contr.

Spudding Date _____

Drig. Data _____

R U R

J. G. MCGHEE

