

KANSAS


FORM 51 5M 2-38 TPCO.

Barton

Section 1 Township 16 Range 14-W

Well No. 6 Schneider "B"

Company Shell

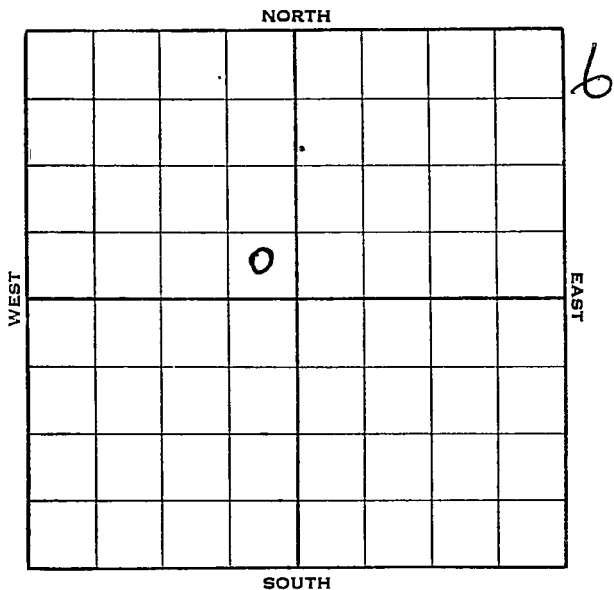

Barton KANSAS

Map No. 73 Sec. 1 Twp. 16 R. 14WWell No. 6 Schneider "B"Shell

Company

Contractor

FIRST REPORT

SE NW

 Ft. from N. Line330 Ft. from S. Line330 Ft. from E. Line Ft. from W. Line

SECTION PLAT

	0		

Location Rig up

Drilling and Remarks:

BRR

RECORD

Cased in., ft.Sand Gas Oil Total Depth

PRODUCTION

1st 24 hrs. Nat. 1st 24 hrs. after shot Gas Cu. Ft.Dry Hole Abandoned

Date

JUN 1 - 1938 19 H. D. Hatfield Scout

Barton, KANSAS

Map No. 73 Sec. 1 Twp. 16 R. 14W

Well No. 6 Schneider "B"

Shell Company

Contractor

COMPLETED

SE NW

SECTION PLAT

 Ft. from N. Line

330 Ft. from S. Line

330 Ft. from E. Line

 Ft. from W. Line

	0		

Location

Rig up

Drilling and Remarks:

2000 acid

Pump 360/4 x 295/4

POT 1793

RECORD

Cased 7 in.; 3323 ft.

Sand Arb 3323

Gas

Oil

Total Depth 3337

PRODUCTION

1st 24 hrs. Nat.

1st 24 hrs. after shot

Gas Cu. Ft.

Dry Hole

Abandoned

Date

JUN 29 1938

19

H. D. Hatfield Scout