

Barton


KANSAS

FORM 51 5M 2-38 TPCO.

Section 1 Township 16 Range 14-W

Well No. 8 Schneider "B"

Company Shell

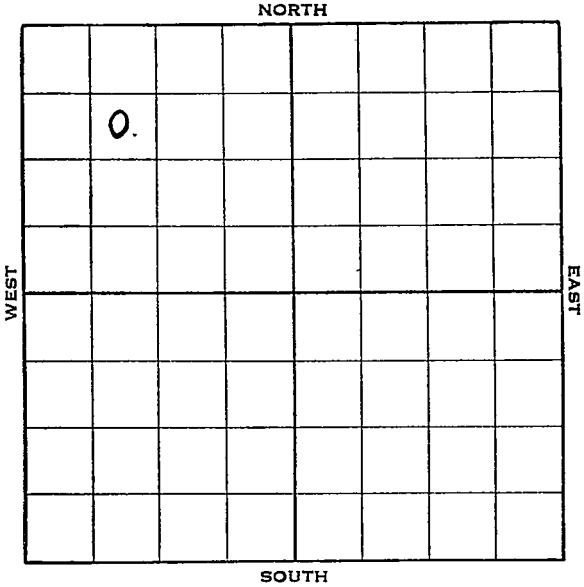

KANSAS

Barton

Sec. 1 Twp. 16 R. 14-7


Well No. #8 Schneider "B" Farm \_\_\_\_\_  
Shell Company \_\_\_\_\_

990 Ft. from N. Line

\_\_\_\_\_ Ft. from S. Line

\_\_\_\_\_ Ft. from E. Line

990 Ft. from W. Line

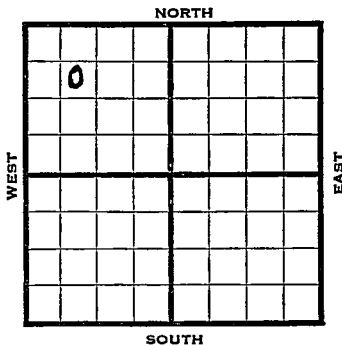

Elev. 1862'

1938	REPORT
9/21	Location
9/30	10" - 650'. .WOC. .
10/7	Topeka 2763'.. Dlg. 2885'..
10/14	Arb. 3285-90'. 7" - 3289'.
10/21	T. D. 3302'. Swab 116 oil in 8 hrs.
10/26	7" - 3289'.
	Arb. 3285'..
	T. D. 3312'.
	6000 acid.
	Potential 2176 bbls.
	<b>COMPLETED</b>

Map No. 73 Sec. 1 Twp. 16 R. 14W

Well No. 8 Schneider "B"

Shell

Company

Contractor

FIRST REPORT

SE NW NW

990 Ft. from N. Line

\_\_\_\_\_ Ft. from S. Line

\_\_\_\_\_ Ft. from E. Line

990 Ft. from W. Line

SECTION PLAT

0			

Location X

Rig up \_\_\_\_\_

Drilling and Remarks:

RECORD

Cased \_\_\_\_\_ in., \_\_\_\_\_ ft.

Sand \_\_\_\_\_

Gas \_\_\_\_\_

Oil \_\_\_\_\_

Total Depth \_\_\_\_\_

PRODUCTION

1st 24 hrs. Nat. \_\_\_\_\_

1st 24 hrs. after shot \_\_\_\_\_

Gas \_\_\_\_\_ Cu. Ft.

Dry Hole \_\_\_\_\_

Abandoned \_\_\_\_\_

Date

SEP 21 1938

19

H. D. Hatfield

Scout

Map No. \_\_\_\_\_ Sec. 1 Twp. 16 R. 14W

Well No. 8-Schneider "B"

Shell \_\_\_\_\_ Company

\_\_\_\_\_ Contractor

**COMPLETED**

SE NW NW

990 Ft. from N. Line

\_\_\_\_\_ Ft. from S. Line

\_\_\_\_\_ Ft. from E. Line

990 Ft. from W. Line

**SECTION PLAT**

0			

Location \_\_\_\_\_

Rig up \_\_\_\_\_

Drilling and Remarks:

*6000 Acid*

*POT 2176*

**RECORD**

Cased 7 in., 3289 ft.

Sand Arb 3285

Gas \_\_\_\_\_

Oil \_\_\_\_\_

Total Depth 3312

**PRODUCTION**

1st 24 hrs. Nat. \_\_\_\_\_

1st 24 hrs. after shot \_\_\_\_\_

Gas \_\_\_\_\_ Cu. Ft.

Dry Hole \_\_\_\_\_

Abandoned \_\_\_\_\_

Date

*OCT 26 1938*

19

*H. D. Hatfield*

Scout