


Section 21 Township 14 Range 13W

Well No. #2 Graham (B)

Company Jayhawk Well Service

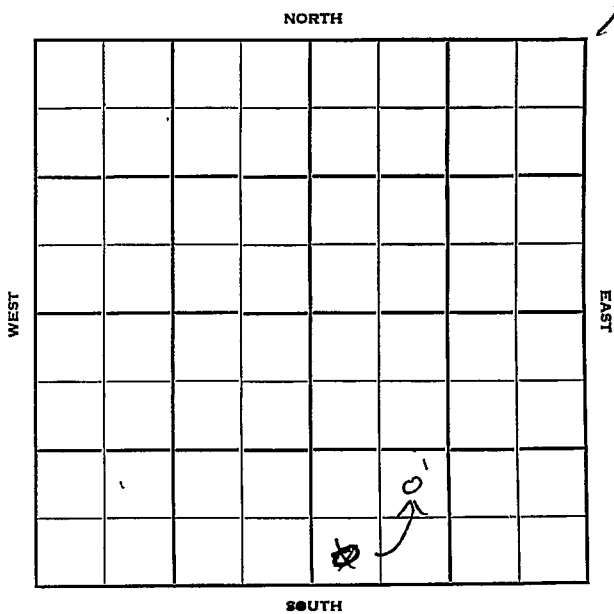

Sec. 21 Twp. 14 R. 13 W

Well No. # 2 Graham (B) Farm

Jayhawk Well Service Company

Contractor

Ft. from N. Line


990  
~~330~~

Ft. from S. Line

Ft. from E. Line

800  
~~330~~

Ft. from W. Line

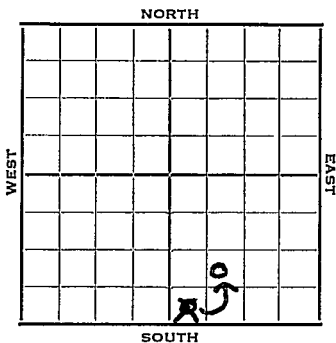

~~SW SW SE~~  
**NE SW SE (twin)**

1952' Elev. 1745' REPORT

- 6/25 Location
- 7/9 RU
- 7/17 15" @ 41 12" @ 405  
Drlg. 475'
- 7/23 10" @ 707'  
Anhy 705'  
Drlg. 1425'
- 7/30 Drlg. 2125'
- 8/6 Tar 2295 TD 2315  
5" @ 2302'
- 8/13 Spud 7-10-52  
Oil Well TD 2312'  
15" @ 41' 12" @ 405'  
10" @ 707'  
Anhy 705' Tar. 2306  
TD 2312' 5" @ 2310' CO to 2312  
8½ boph oil-frac S/ 6 boph  
Comp. 50 bopd

**COMPLETED**





KADSD

Map No. \_\_\_\_\_ Sec. 21 Twp. 14 R. 13W

Well No. 2 Graham "B" (twin)

Jayhawk Well Service Company

**CORRECTION**

Contractor

NE SW SE

1765

**SECTION PLAT**

\_\_\_\_\_ Ft. from N. Line

990 Ft. from S. Line

\_\_\_\_\_ Ft. from E. Line

800

~~990~~ Ft. from W. Line

		0	

Russell County

Location \_\_\_\_\_

Rig up \_\_\_\_\_

Drilling and Remarks:

Reported

SW SW SE

**RECORD**

Cased \_\_\_\_\_ in., \_\_\_\_\_ ft.

Sand \_\_\_\_\_

Gas \_\_\_\_\_

Oil \_\_\_\_\_

Total Depth \_\_\_\_\_

**PRODUCTION**

1st 24 hrs. Nat. \_\_\_\_\_

1st 24 hrs. after shot \_\_\_\_\_

Gas \_\_\_\_\_ Cu. Ft.

Dry Hole \_\_\_\_\_

Abandoned \_\_\_\_\_

Date

JUL 9 1952 19

J. G. McGEHEE Scout