


Section 2 Township 16 Range 14W

Well No. #1 Schneider

Company El Dorado Ref.

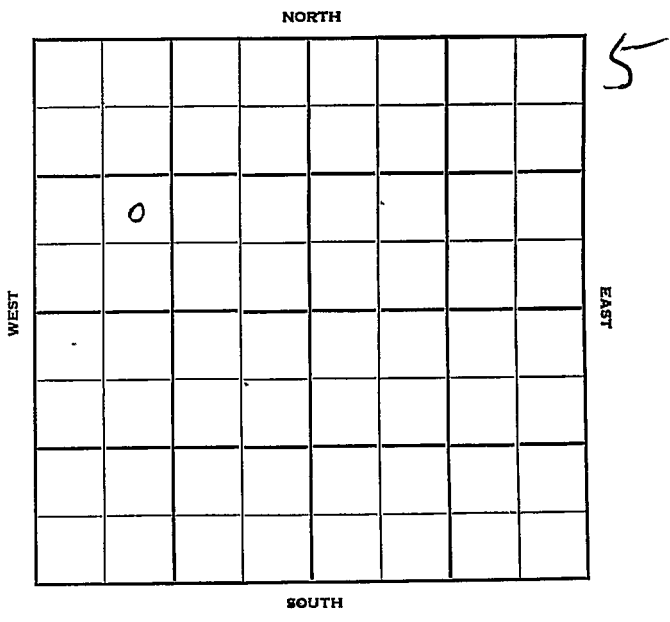

Barton

KANSAS

Sec. 2 Twp. 16 R. 14W ☒

Well No. #1 Schneider Farm

El Dorado Refg. Company

B & R Drlg. - Contr. Contractor

Trapp Pool


 Ft. from N. Line

990' Ft. from S. Line

 Ft. from E. Line

990' Ft. from W. Line

NE SW NW

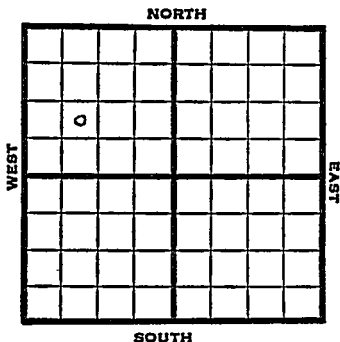

1951

Elev. 1885' REPORT

4/18

Location

5/9

Spud 4-18-51

D & A TD 3369' 8" @ 409'

Anhy 876', Heeb 3023', Lans. 3089'

U Cong. 3321' Arb. 3354'

DST 3354-69 open 45 min. rec 37' mud

TD 3369' D & A

ABANDONED

County Barton State KansasSec. 2 (Blk. Twp.) 16 (Sur. Rge.) 14W Map No. 1Operator Eldorado Ref.Well No. 1 Farm SchneiderElev. _____ Location NE SW NW

0

FIRST REPORT

990 Ft. From S Line NW990 Ft. From W Line Quarter1st. Report. APR 18 1951

Completion _____

Remarks _____


B & R Drlg. - Contr.

Spudding Date _____

Drlg. Data Trapp Pool

Location _____

J. E. TYRA

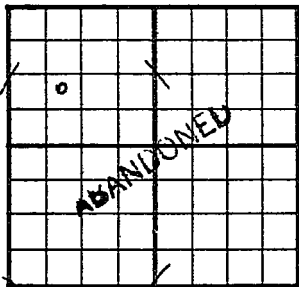County Barton State KansasSec. 2 (Blk.
Twp.) 16 (Sur.
Rge.) 14W Map No.Operator Eldorado Ref.Well No. 1 Farm SchneiderElev. 1885 Location NE SW NW990 Ft. From S Line NW990 Ft. From W Line Quarter1st. ReportCompletion MAY 9 1951Remarks Trapp PoolB & R Drlg. - Contr.Spudding Date 4-18-51Drlg. Data D & A TD 33698" @ 409 Anhy 876 Heeb. 3023Lans. 3089 Cong. 3321 Arb. 3354DST 3354-69 open 45 min. Rec. 37' mudTD 3369 D & A

J. E. TYRA