


BUTLER KANSAS

DX 78-1

Section 21 Township 29 Range 8E
Well No. 1 C. B. Hoard "C"
Company K. T. Weidmann

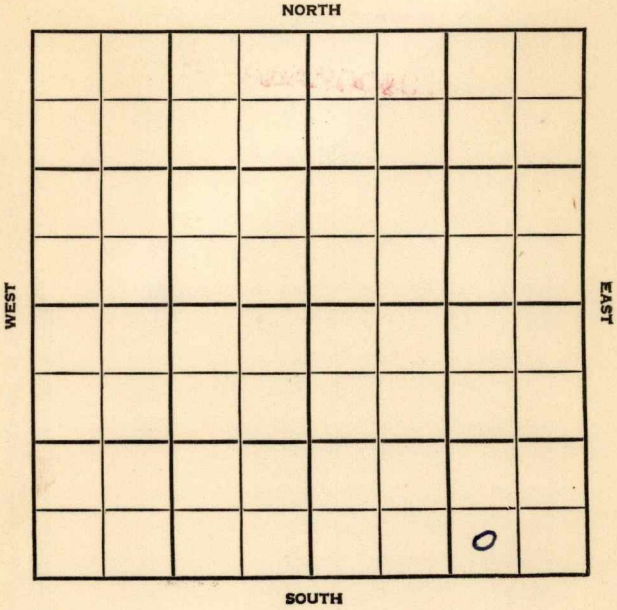


SEC.	TWP.	R.
21	29	8E ✓

WELL NO. _____
 COMPANY **1 C. B. Hoard "C"** FARM

CONTRACTOR **K. T. Weidemann**

Shinn Pool

_____ Ft. from N. Line
330 _____ Ft. from S. Line
990 _____ Ft. from E. Line
 _____ Ft. from W. Line

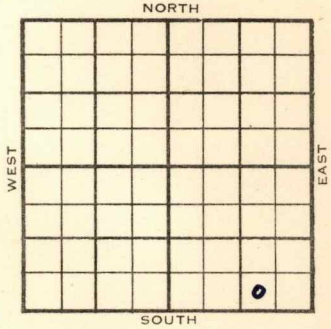

SW SE SE

	ELEVATION	REPORT
1954	-	

6/23 Spud 6-16-54
 Miss 2820', Arb. 3133'
 TD 3182'
 D&A

FIRST REPORT

ABANDONED

